


TOWN OF LEXINGTON MA



- | | |
|--------------------|-----------------------------|
| OutfallMaster42011 | SubtypeCD |
| SawOutletDaveEdits | AvoidanceChamber |
| <all other values> | JunctionChamber |
| SubtypeCD | Manhole |
| DischargeStructure | SedimentationChamber |
| Headwall | StormSeparator |
| Outfall | WaterSeparator |
| <all other values> | <all other values> |
| SubtypeCD | DischargePoint |
| AirRelease | <all other values> |
| Altitude | SubtypeCD |
| Backflow | Catchbasin |
| DoubleCheck | Headwall |
| SimpleCheck | OverflowRilet |
| VacuumRelease | PrivateConnections |
| <all other values> | PumpStation |
| SubtypeCD | StormwaterNetwork_Junctions |
| <all other values> | <all other values> |
| Ball | SubtypeCD |
| Butterfly | Catchbasin |
| Cone | Headwall |
| Gate | OverflowRilet |
| Plug | PrivateConnections |
| Plug | PumpStation |
| <all other values> | StormwaterNetwork_Junctions |
| SubtypeCD | <all other values> |
| VerticalDeflection | SubtypeCD |
| <all other values> | Catchbasin |
| <all other values> | Headwall |
| <all other values> | OverflowRilet |
| <all other values> | PrivateConnections |
| <all other values> | PumpStation |
| <all other values> | StormwaterNetwork_Junctions |
-
- | | |
|--------------------|-------------|
| <all other values> | LateralLine |
| <all other values> | LateralLine |
| <all other values> | LateralLine |
-
- | | |
|------------------------------------|----|
| 0.2 PCT ANNUAL CHANCE FLOOD HAZARD | A |
| A | AE |
| AE | X |
| X | X |

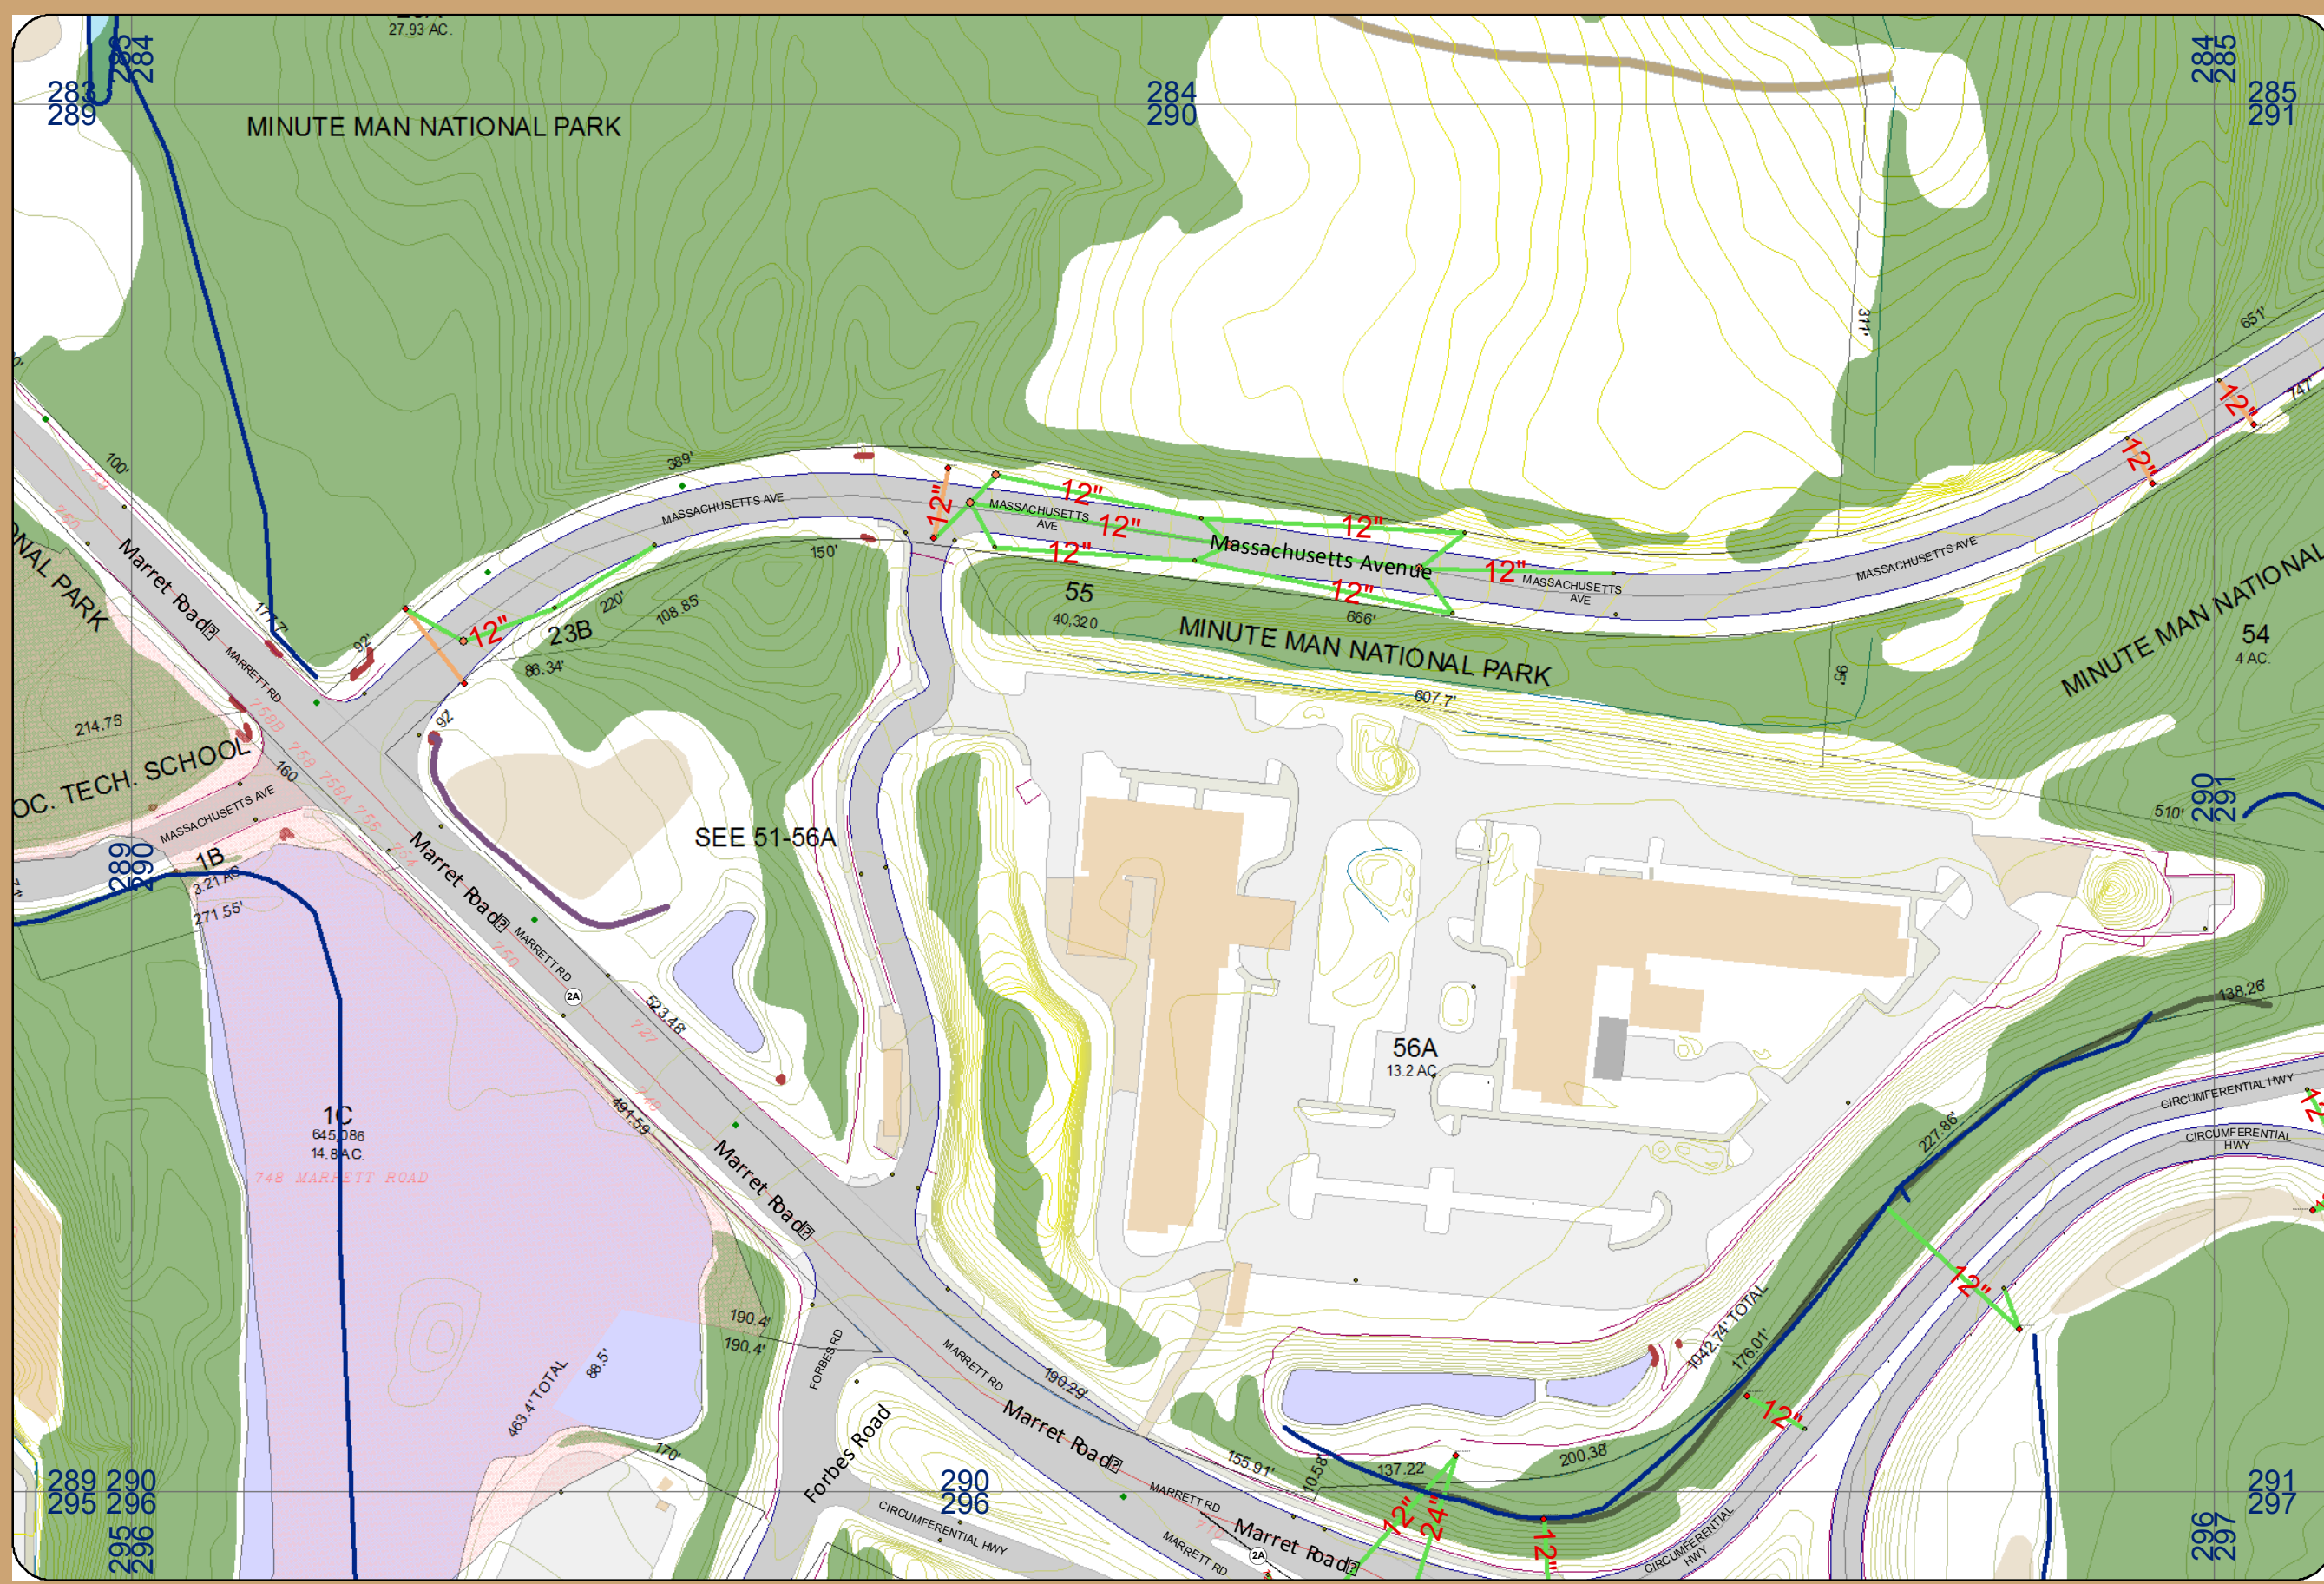

MAP FOR REFERENCE ONLY
NOT A LEGAL DOCUMENT
The Town of Lexington makes no claims and no warranties, concerning the validity, expressed or implied, of the accuracy of the GIS data presented on this map.

DATA SOURCE
MASSGIS 2008 1' ORTHO
TOWN OF LEXINGTON
Engineering Dept - Linked to most current parcel data

COMPILED BY:
JUDY SEPPALA
GIS ADMINISTRATOR
MIS DEPT
TOWN OF LEXINGTON