
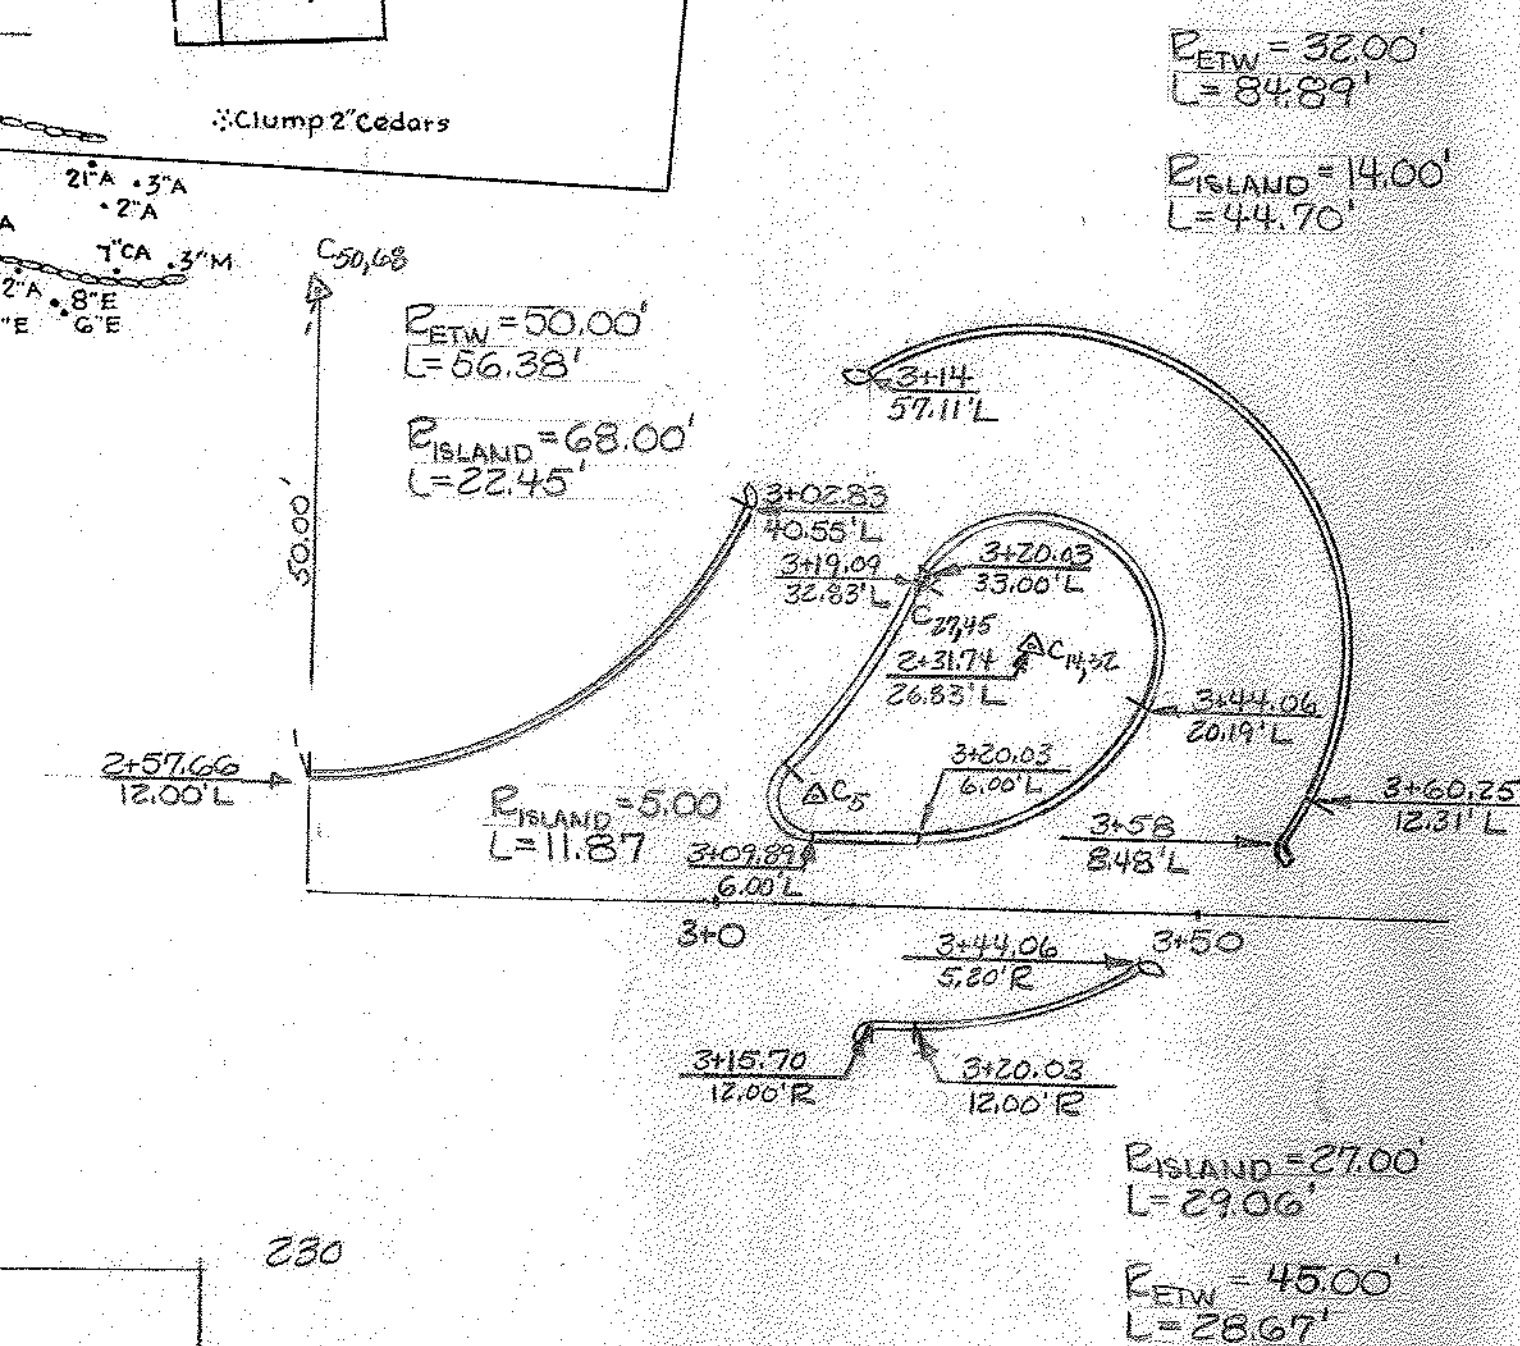



PROFILE  
SCALES HORZ. 1" = 20'  
VERT. 1" = 2'

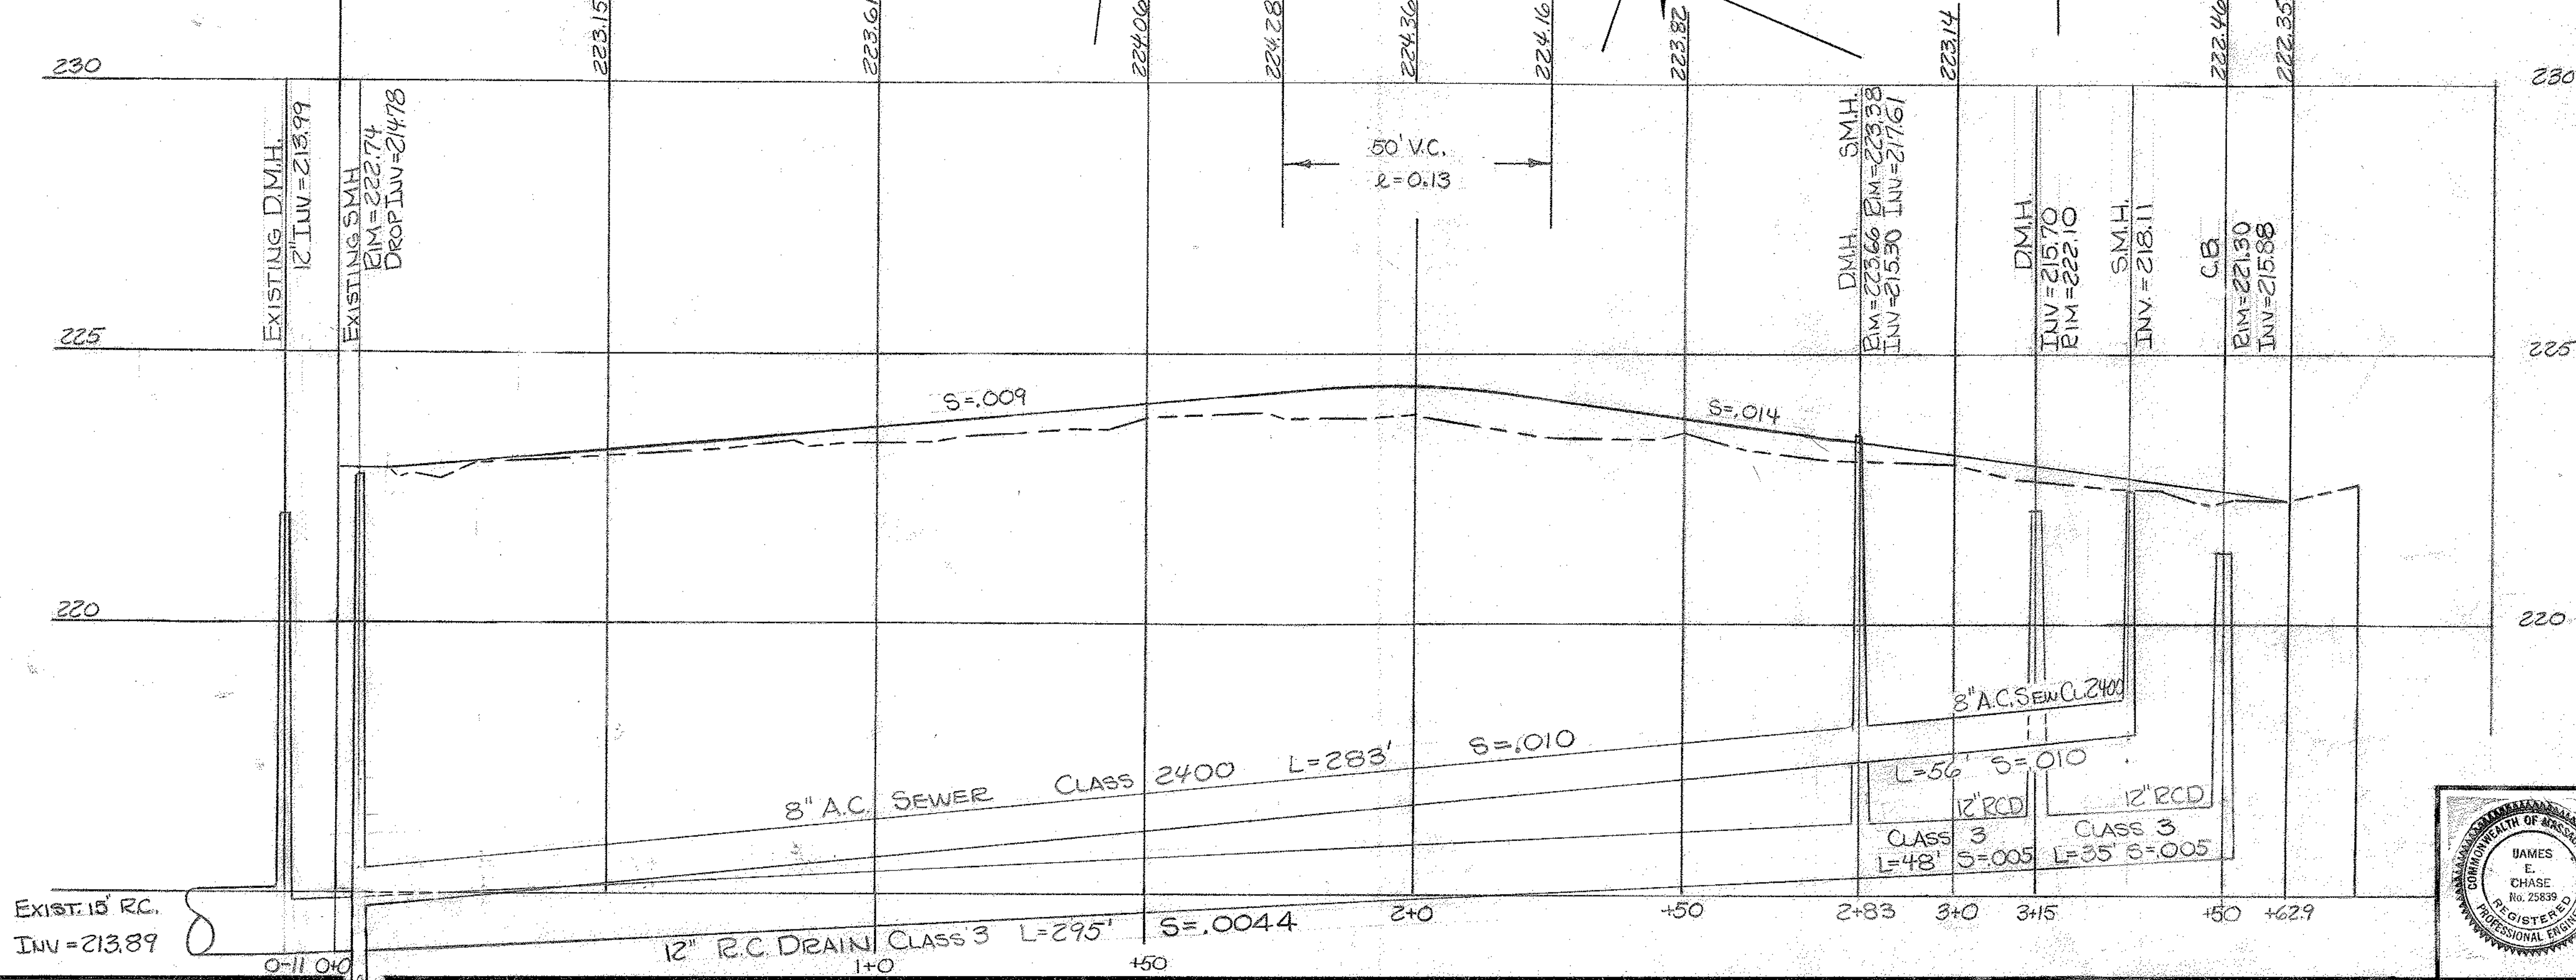

V-1384

TOWN OF LEXINGTON, MASS.  
ENGINEERING DEPARTMENT  
**STREET CONSTRUCTION**  
**BELFRY TERRACE**

DRAWN BY J.C.L. DATE AUG. 1, 1975 SCALES AS NOTED  
DESIGNED BY P.M.C. SHEET 2 OF 7 SHEETS JOB NO. 76-2-E  
CHECKED BY J.E.C. APPROVED *James E. Chase*

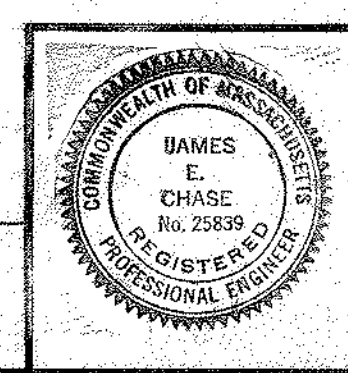

1/17/76 AS BUILT M.E.