



109

LAND & LOTTING LETTER FILE

ANTHONIO & MARIA CAIRA

I HEREBY CERTIFY THAT THIS PLAN WAS PREPARED IN CONFORMANCE WITH THE RULES & REGULATIONS OF THE REGISTER OF DEEDS OF JANUARY, 1976
5-12-77 Theodore E. Dwyer

JOSEPH R. & RUBY M. BELCIX

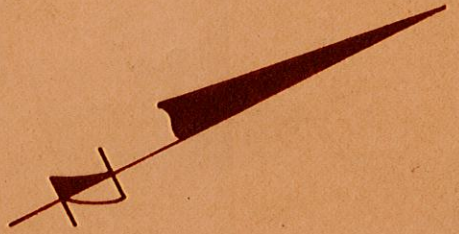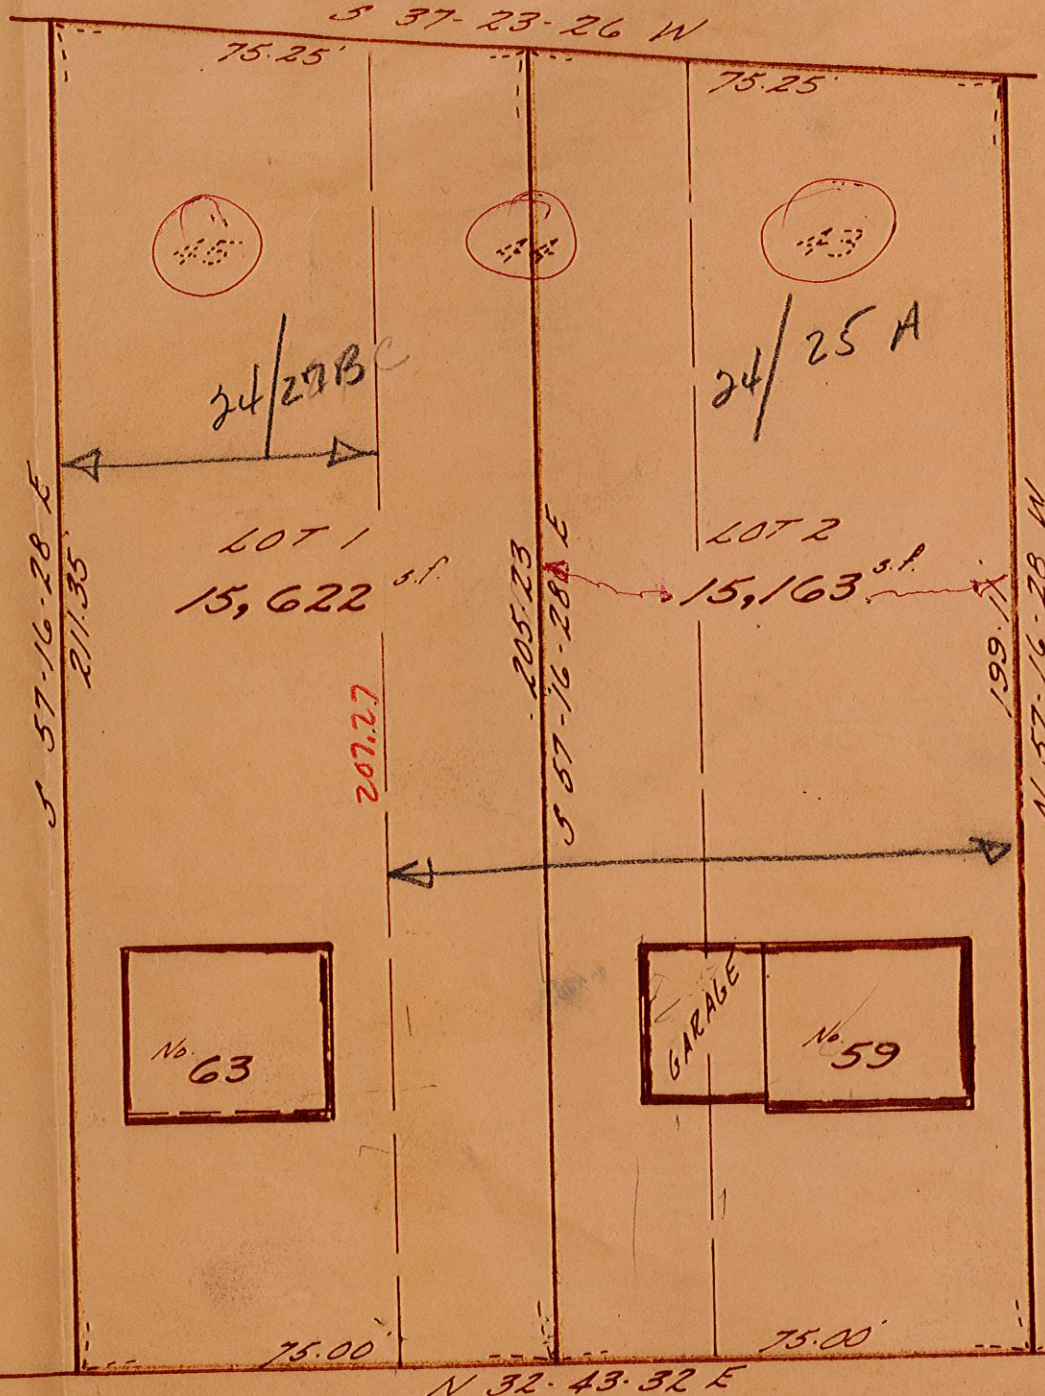

LEXINGTON PLANNING BOARD:
APPROVAL NOT REQUIRED UNDER
THE SUBDIVISION CONTROL LAW

Kenneth A. Briggs

May 23, 1977
DATE

VALLEYFIELD STREET

GRASSLAND STREET

Theodore E. Dwyer

SUBDIVISION PLAN
LEXINGTON, MASS.

OWNED BY
GEORGE H. & MARY A. PIERCE
RALPH J. & MARY E. MASCIULLI

MAY 11, 1977

OTTE & DWYER, INC.
41 ESSEX STREET

SURVEYORS
SAUGUS, MASS.

