



- NOTES:
1. DISCHARGE PIPING AS SHOWN ON THE PUMP STATION SITE PLAN.
 2. PROVIDE RESTRAINED SLEEVE COUPLING CONNECTION FOR FORCE MAIN CONNECTIONS 4'-0" FROM VALVE PIT.
 3. RESTRAIN PIPING TO PREVENT LATERAL MOVEMENT OF PIPING IN VALVE PIT AND WET WELL.

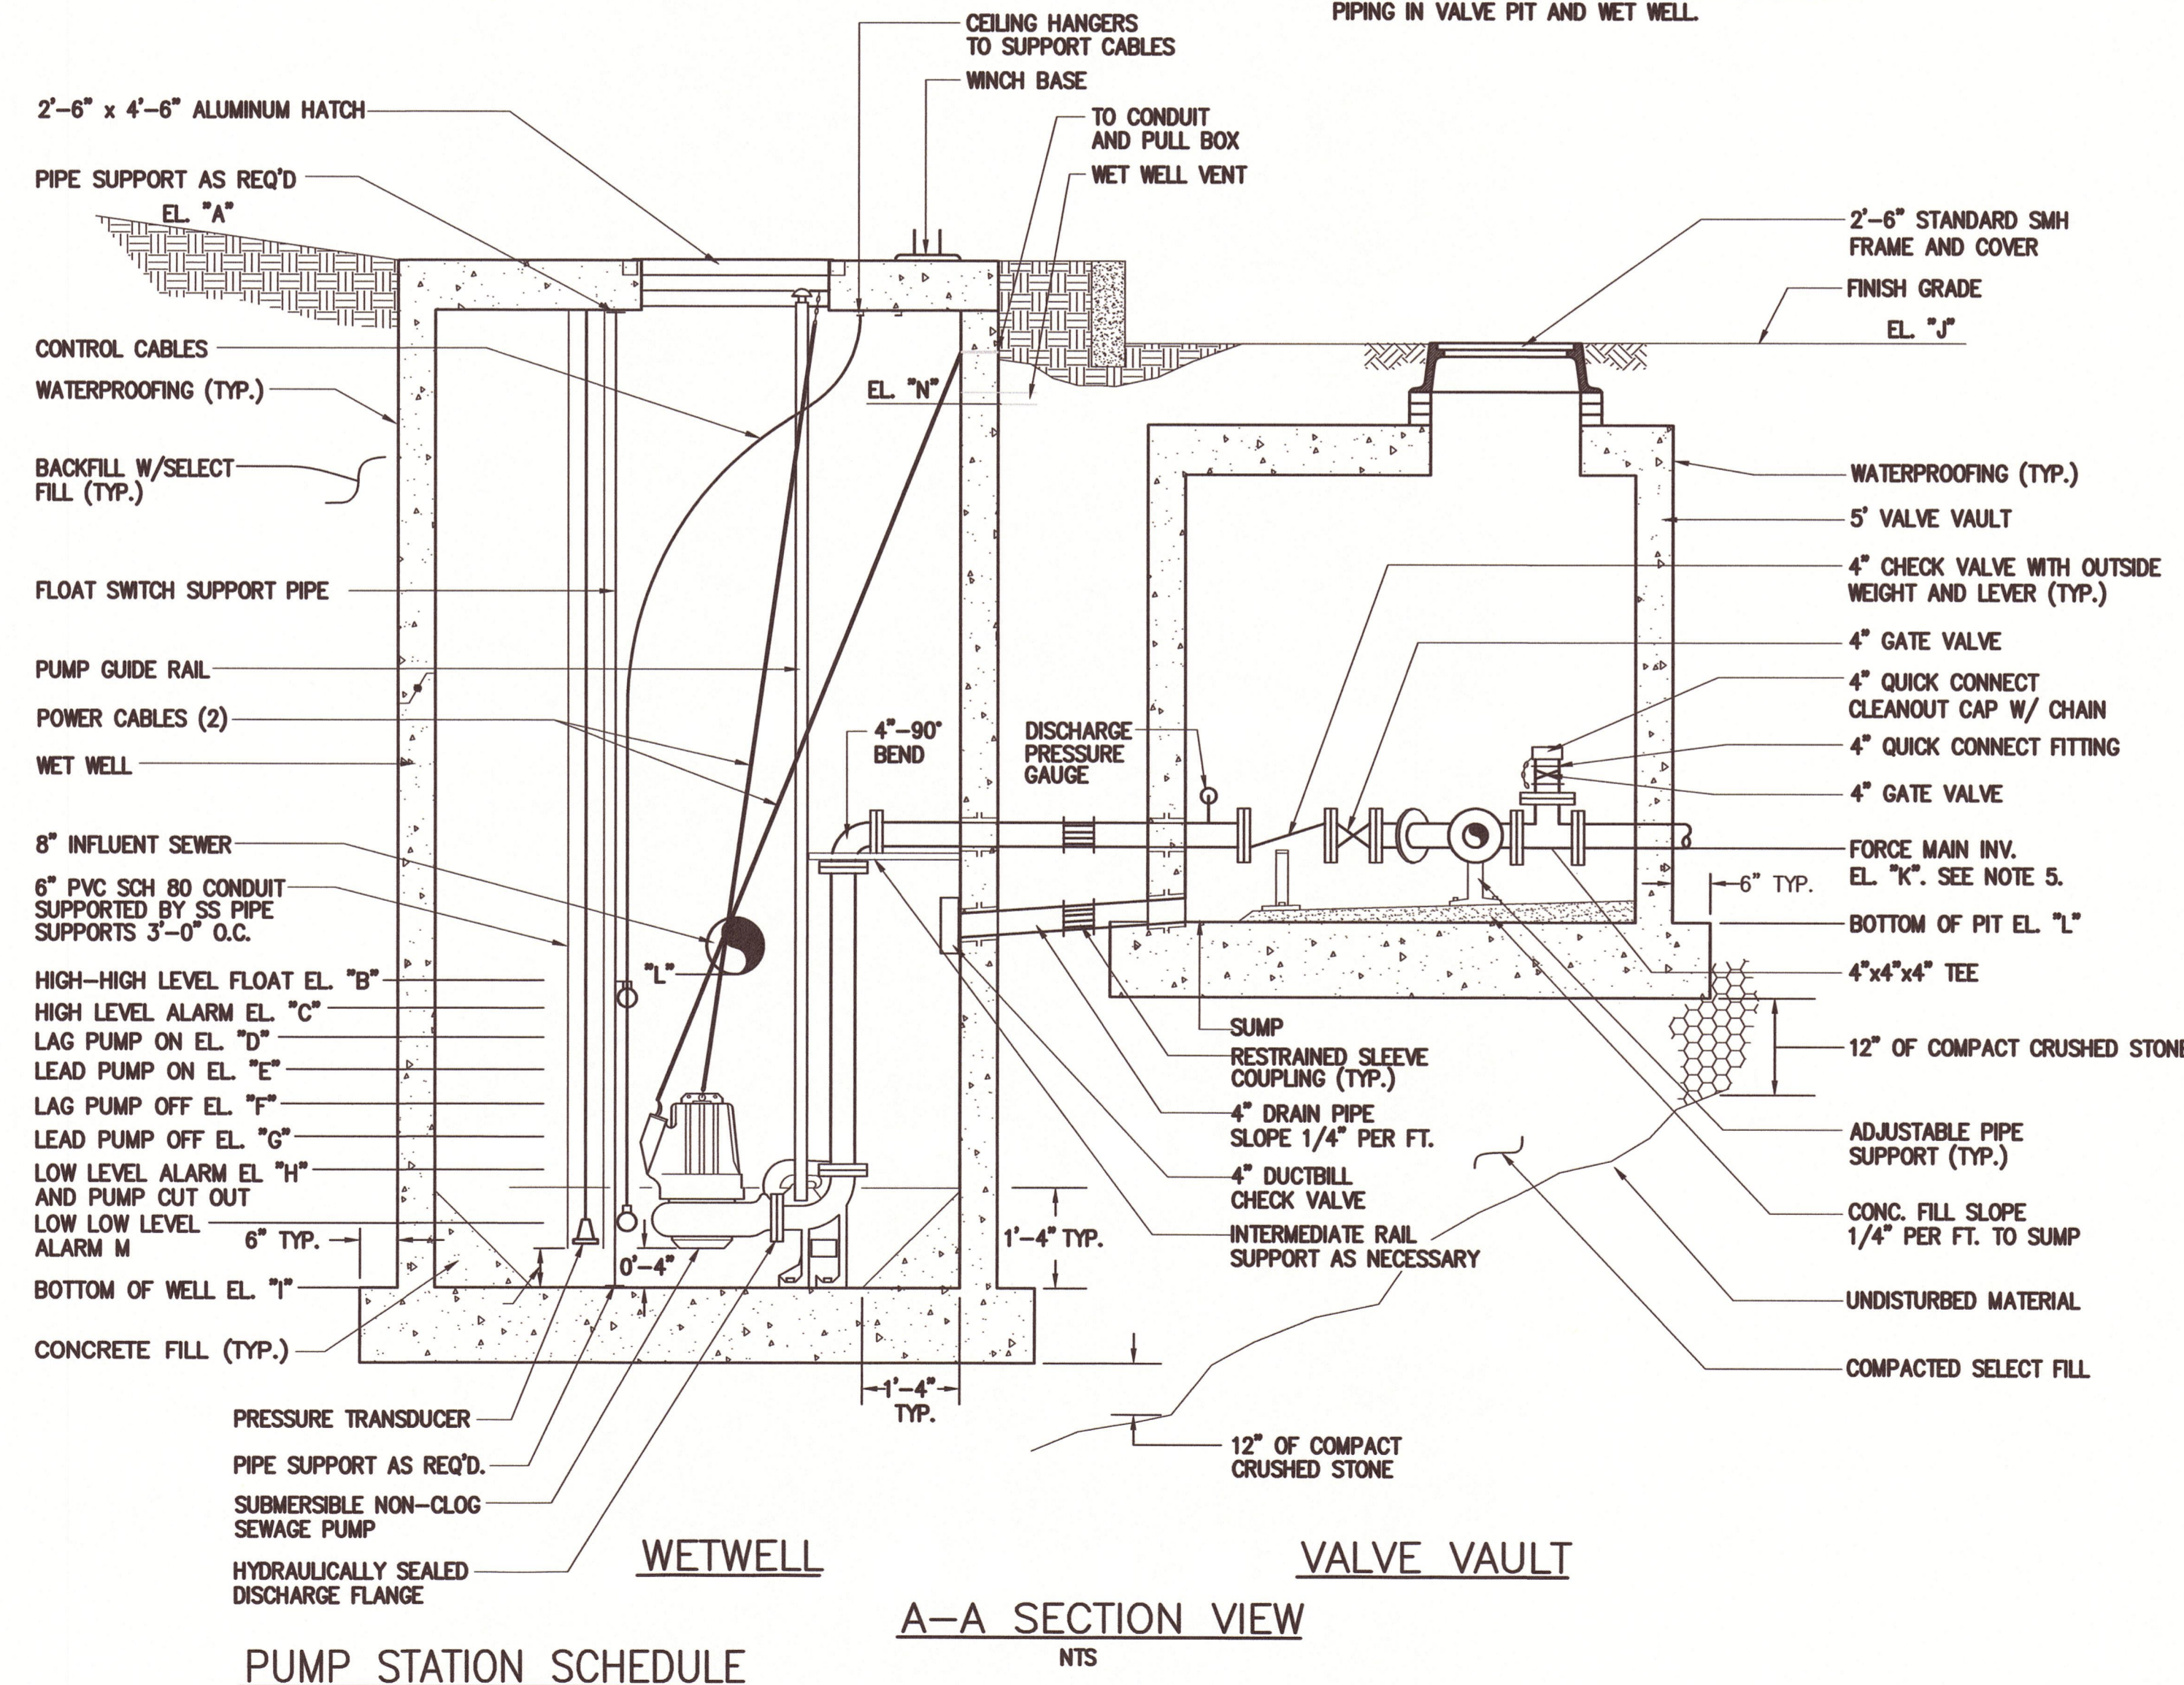

PS LOCATION	DIAMETERS				ELEVATIONS													
	WET WELL	VALVE PIT	INFLUENT SEWER(S)	DISCHARGE PIPING	A	B	C	D	E	F	G	H	I	J	K	L	M	N
MAIN	6'	5'	8"	4"	217.13	208.57	207.63	207.13	206.63	205.21	205.21	204.21	202.50	216.33	209.21	208.44	208.57	212.7

PROPOSED PUMP STATION
SCALE: NTS

SUBMISSIONS/REVISIONS		APP'D	DATE
NO.	ISSUED FOR		
1	FOR BID	KMO	11/14
2	RECORD DRAWINGS	BAY	07/16

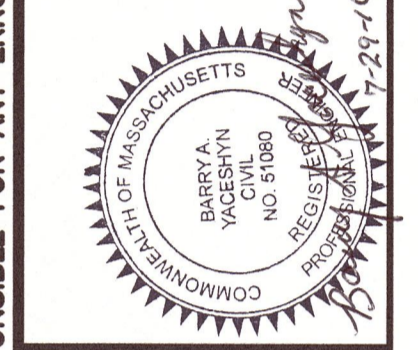

WRIGHT-PIERCE
Engineering a Better Environment
Offices Throughout New England
888.621.8156 | www.wright-pierce.com

TOWN OF LEXINGTON, MA
BRIGHAM ROAD WASTEWATER
PUMP STATION UPGRADE

EXISTING AND PROPOSED SECTIONS

DRAWING
C-4

THESE RECORD DRAWINGS HAVE BEEN PREPARED, IN PART, ON THE BASIS OF THE INFORMATION COMPILED AND FURNISHED BY OTHERS. THE ENGINEER WILL NOT BE RESPONSIBLE FOR ANY ERRORS OR OMISSIONS WHICH HAVE BEEN INCORPORATED INTO THIS DOCUMENT AS A RESULT.