

TOWN OF LEXINGTON, MASSACHUSETTS


DEPARTMENT OF PUBLIC WORKS

RECORD DRAWINGS FOR

BRIGHAM ROAD WASTEWATER

PUMP STATION UPGRADE

CONTRACT NO. PW 15-40

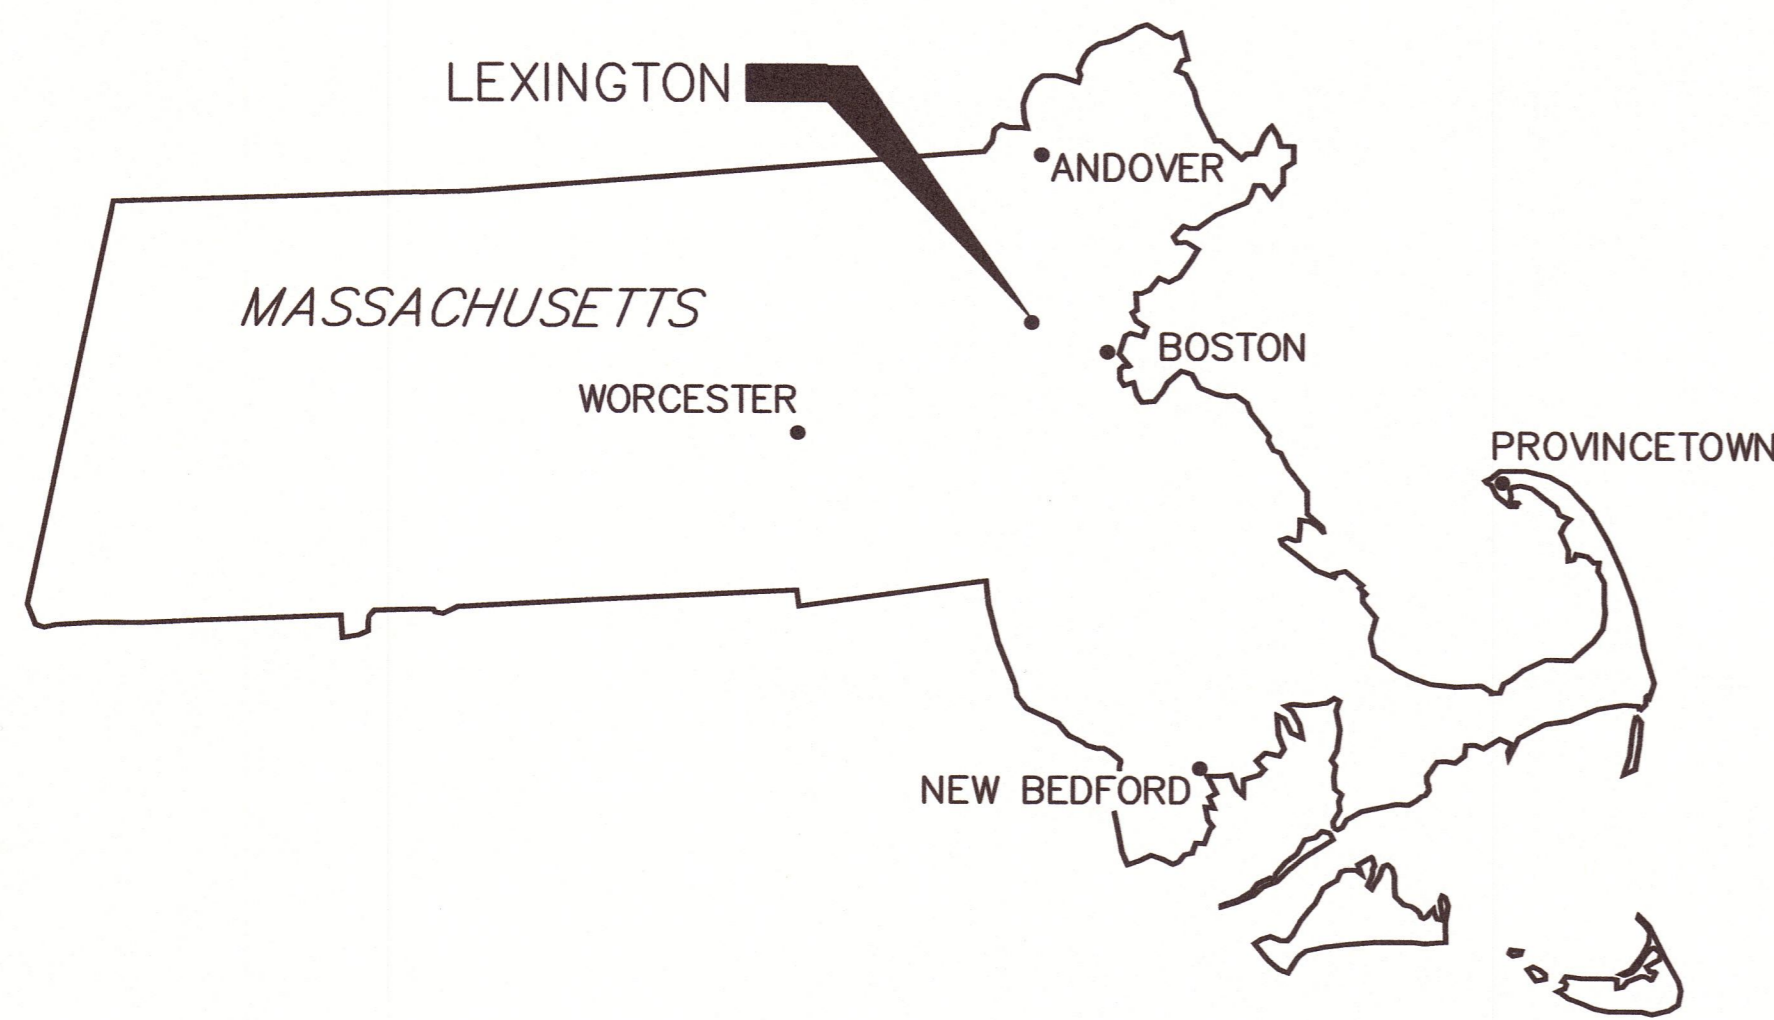

DRAWING INDEX

GENERAL

--- COVER SHEET

CIVIL



C-1 GENERAL CIVIL NOTES AND LEGEND
 C-2 EXISTING CONDITIONS AND DEMOLITION PLAN
 C-3 PROPOSED SITE PLAN AND PROFILE
 C-4 EXISTING AND PROPOSED SECTIONS
 C-5 DETAILS I
 C-6 DETAILS II
 C-7 DETAILS III

INSTRUMENTATION

I-1 INSTRUMENTATION LEGEND, NOTES AND ABBREVIATIONS
 I-2 INSTRUMENTATION LOOPS

ELECTRICAL

E-1 ELECTRICAL LEGEND, NOTES, ABBREVIATIONS AND NEMA SCHEDULE
 E-2 SINGLE LINE DIAGRAMS
 E-3 ELECTRICAL DEMOLITION AND MODIFICATION SITE PLANS AND ELECTRICAL ELEVATIONS
 E-4 ELECTRICAL SCHEMATICS AND DETAILS

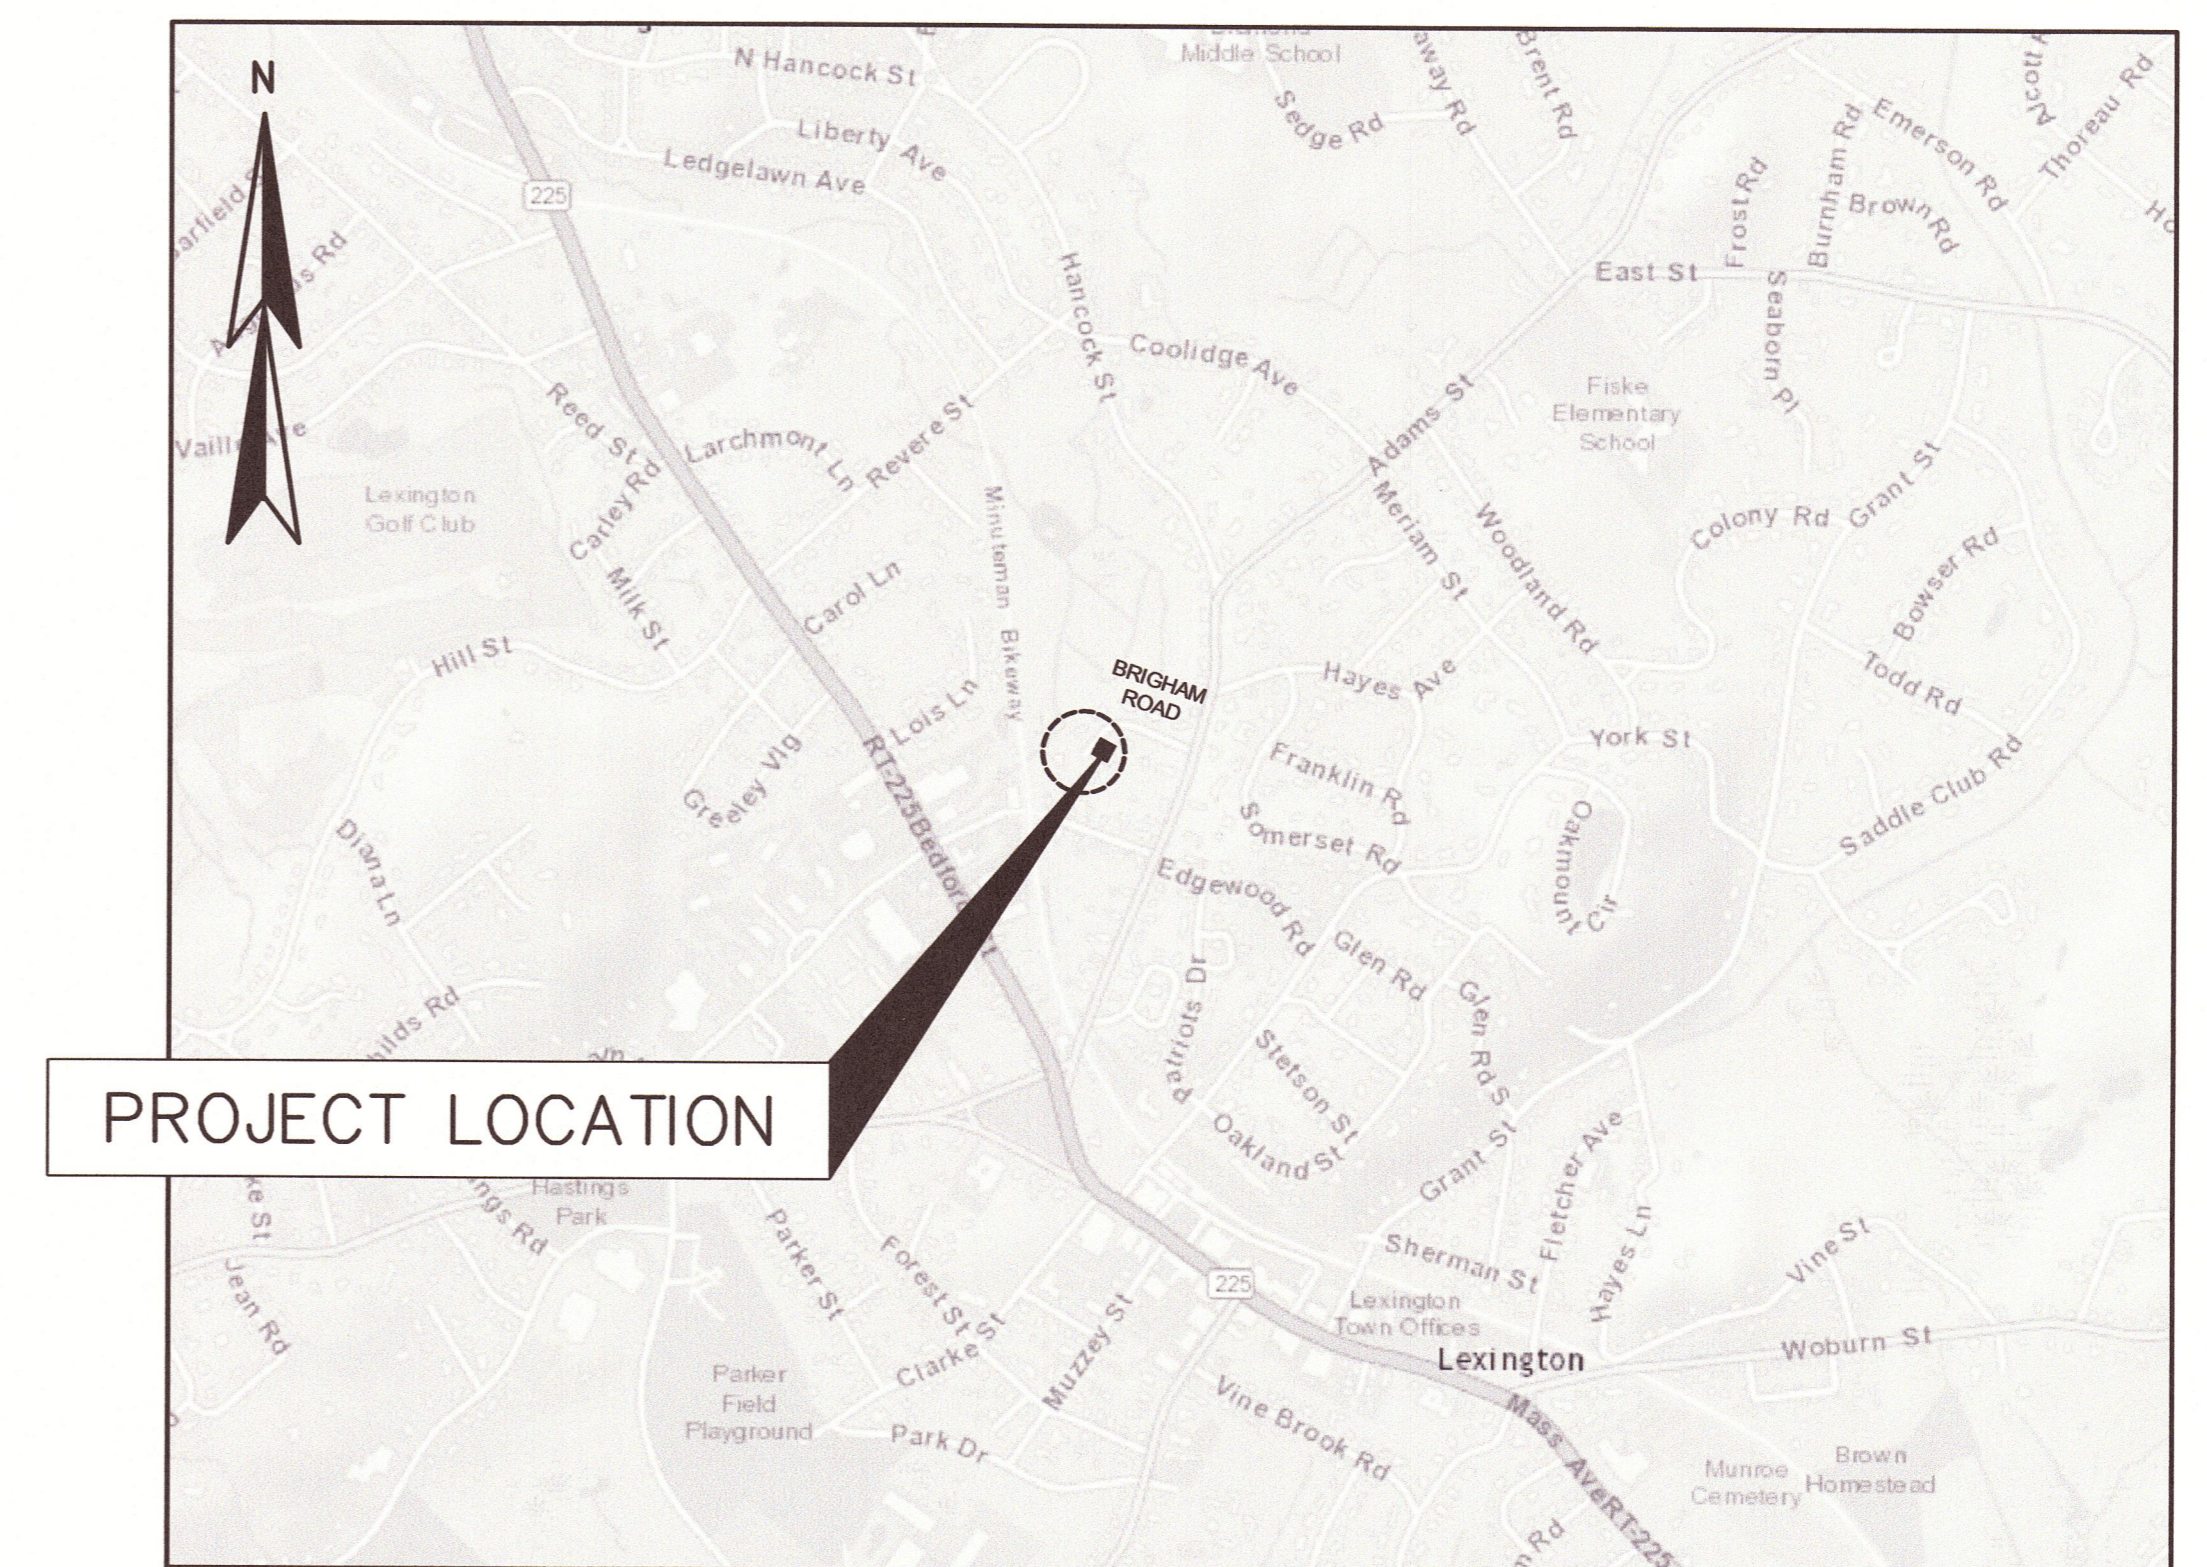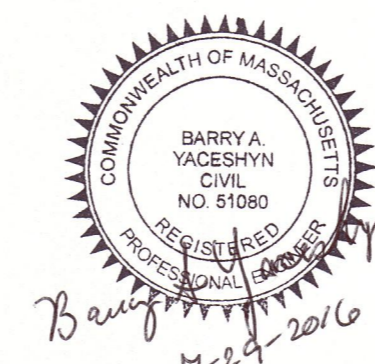

LOCATION PLAN
 NTS

WRIGHT-PIERCE 
 Engineering a Better Environment

Offices Throughout New England
 888.621.8156 | www.wright-pierce.com

FOR REVIEW: **OCTOBER 2014**
 FOR BIDDING: **DECEMBER 2014**
 WP PROJECT NO. 12938A