


RECORD DRAWING	DATE	4/30/91
APP. BY	DESCRIPTION	
DR. BY	DATE	
CHK. BY	DATE	
APP. BY	DATE	
REG. PROFESSIONAL ENGINEER		



TOWN OF LEXINGTON, MASSACHUSETTS DEPARTMENT OF PUBLIC WORKS NORTH LEXINGTON MAIN PUMPING STATION	SCALE	AS NOTED	CONTRACT	92-1	JOB NO.	9065	DR. BY	MS	APP. BY	EDS
MISCELLANEOUS DETAILS AND SCHEDULES										
CARD NO.	169-49									

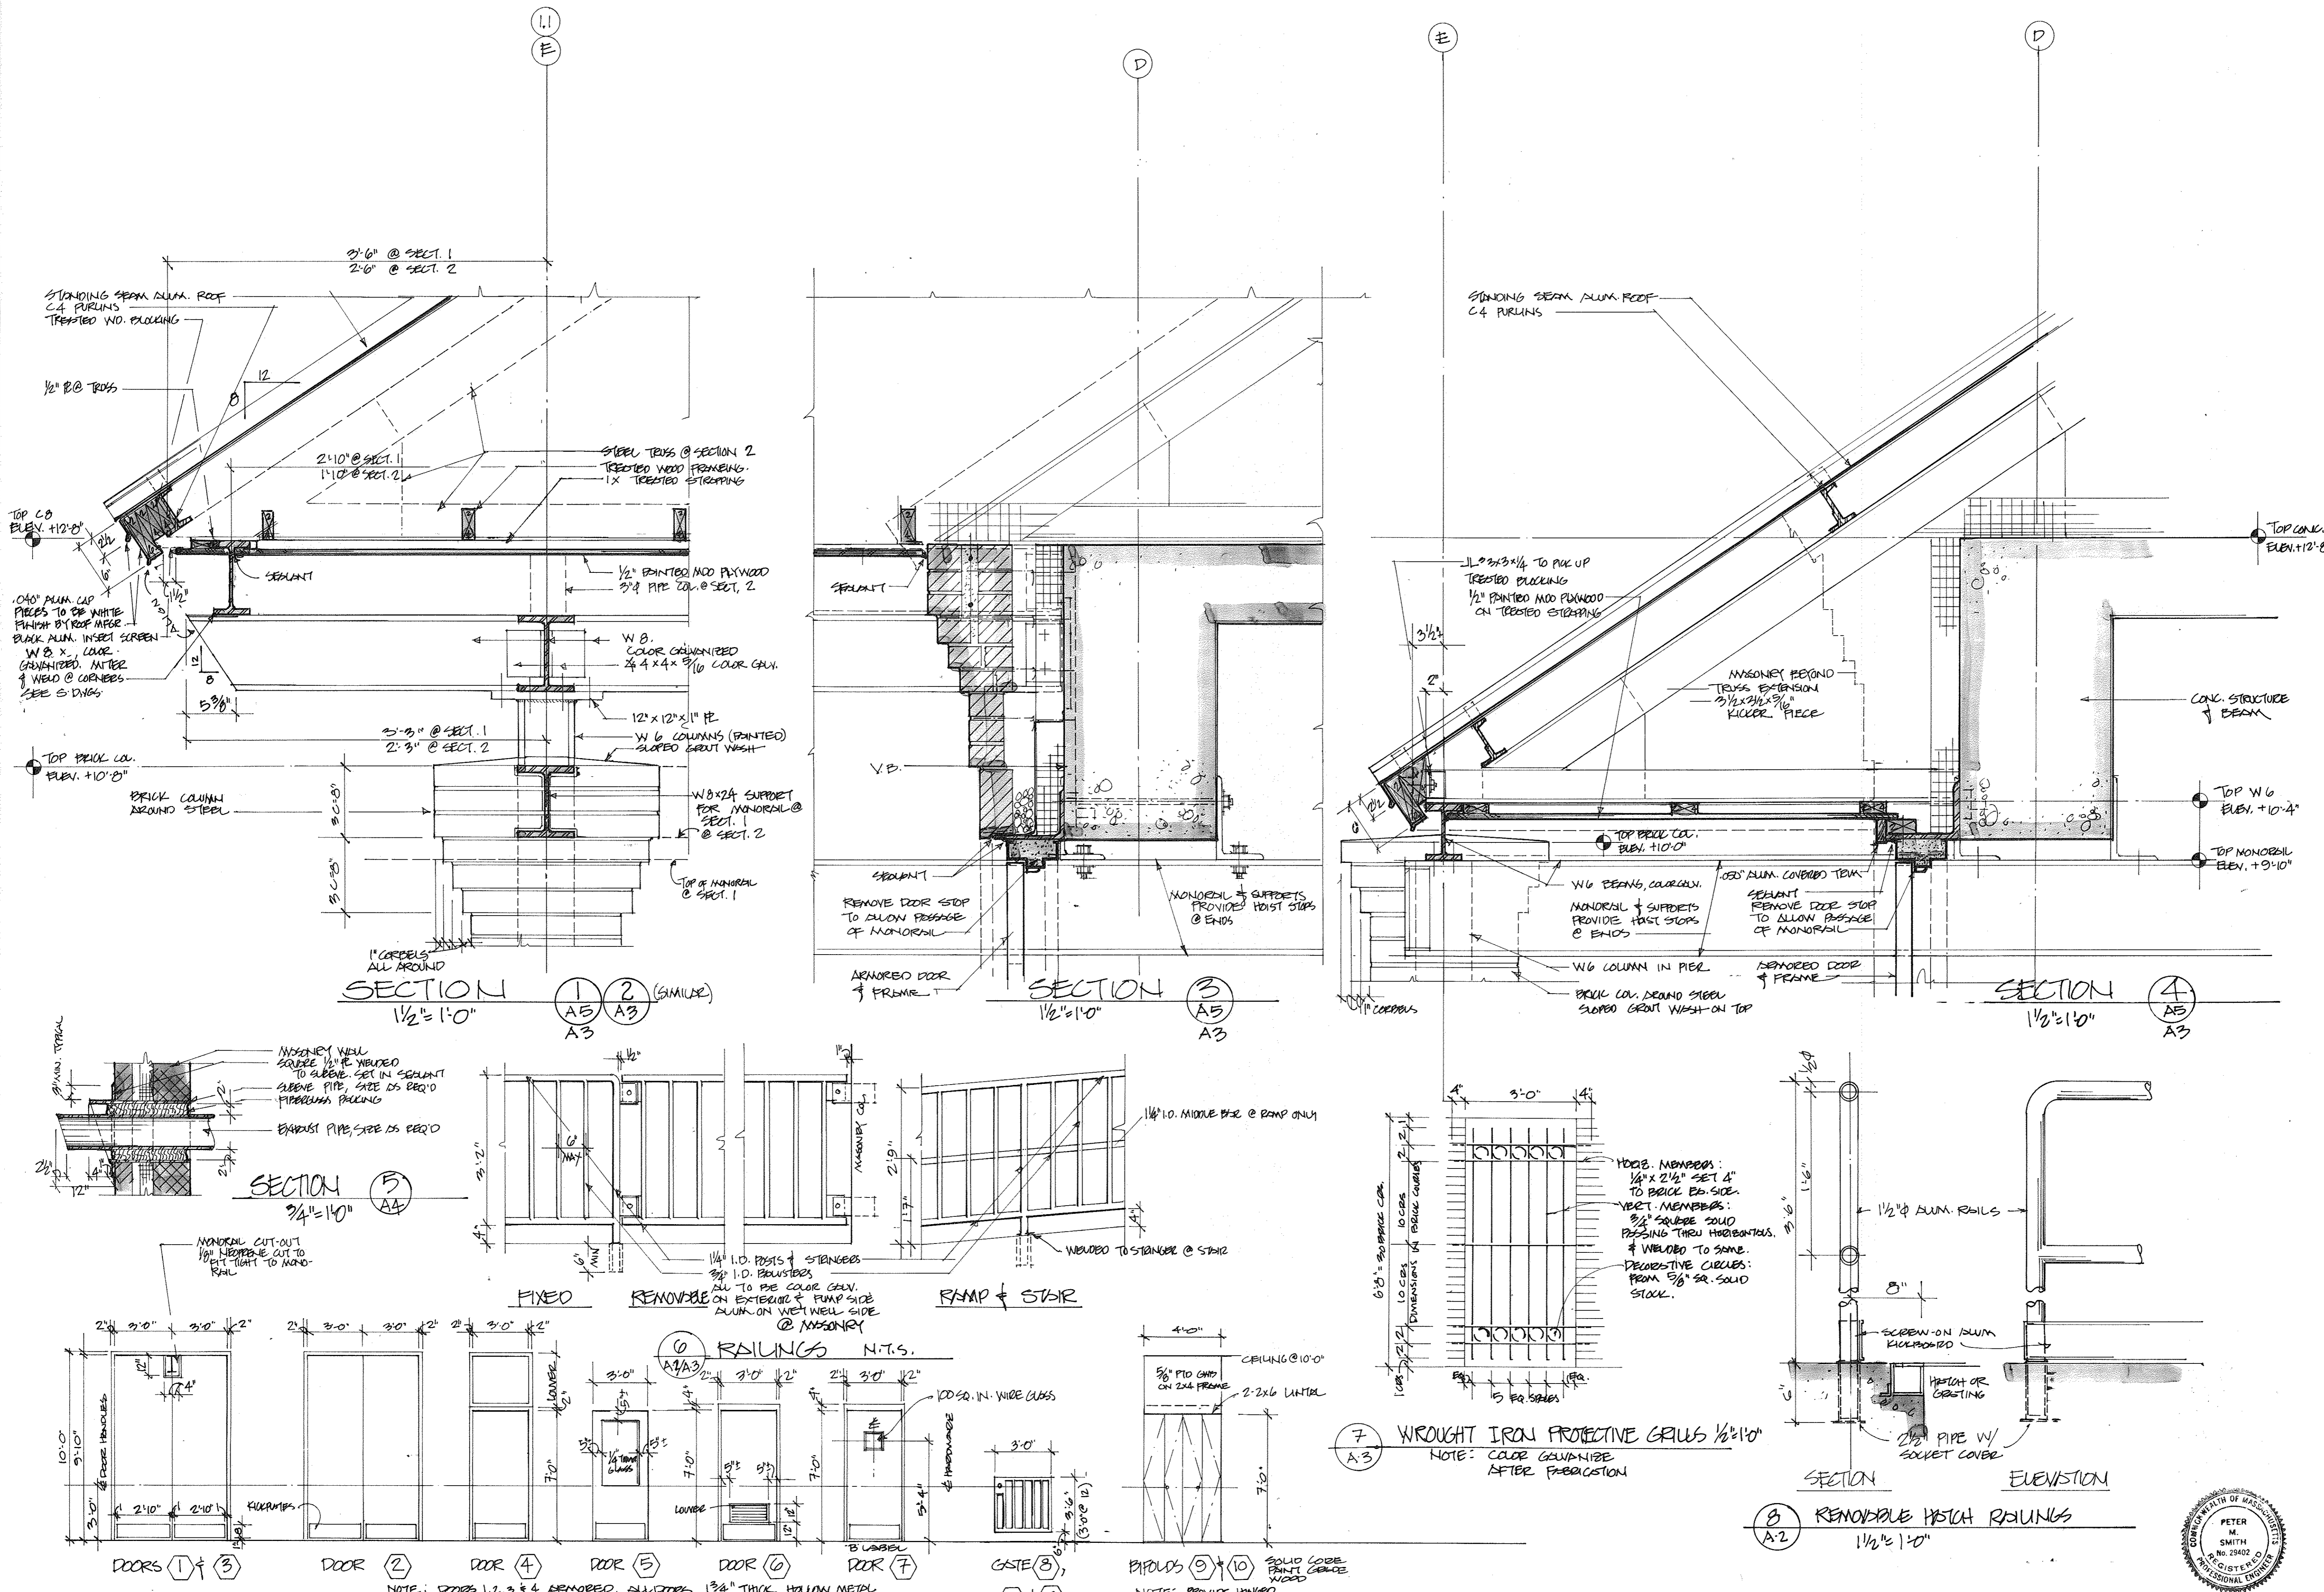

RECORD DRAWING