




PROFILE A
SCALE: 1"=10' H
1"=4' V

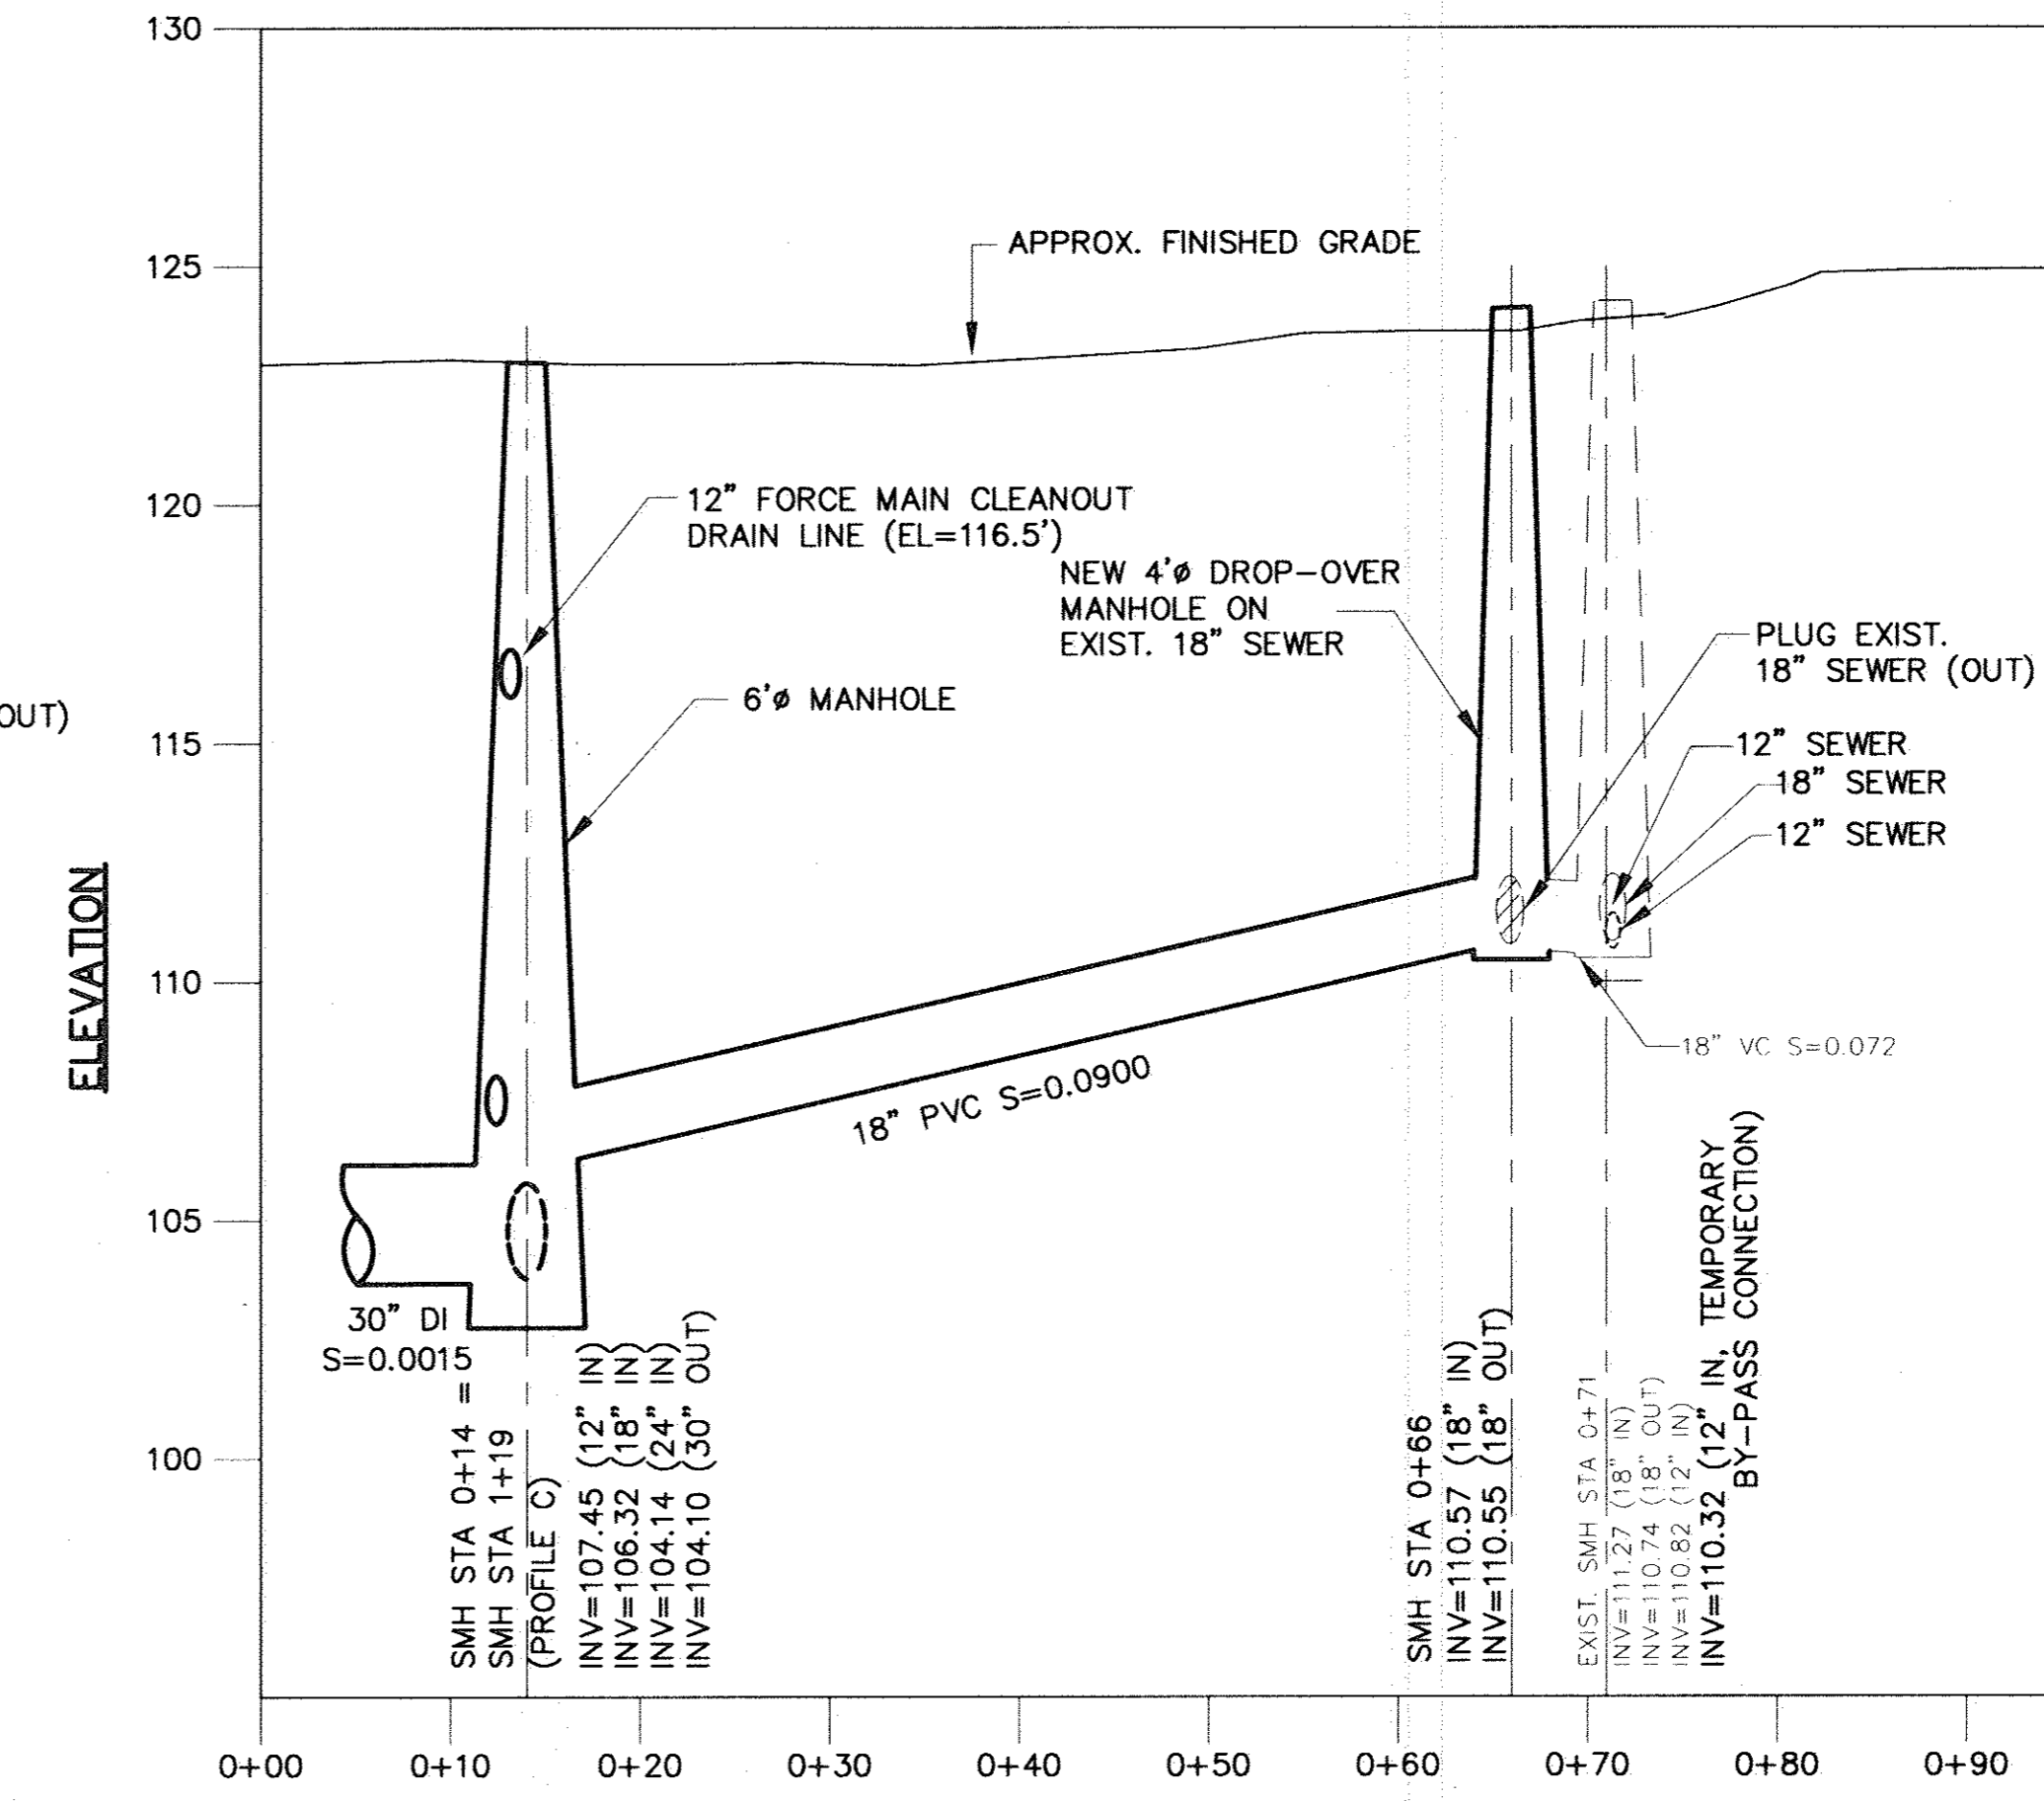


PROFILE B
SCALE: 1"=10' H
1"=4' V

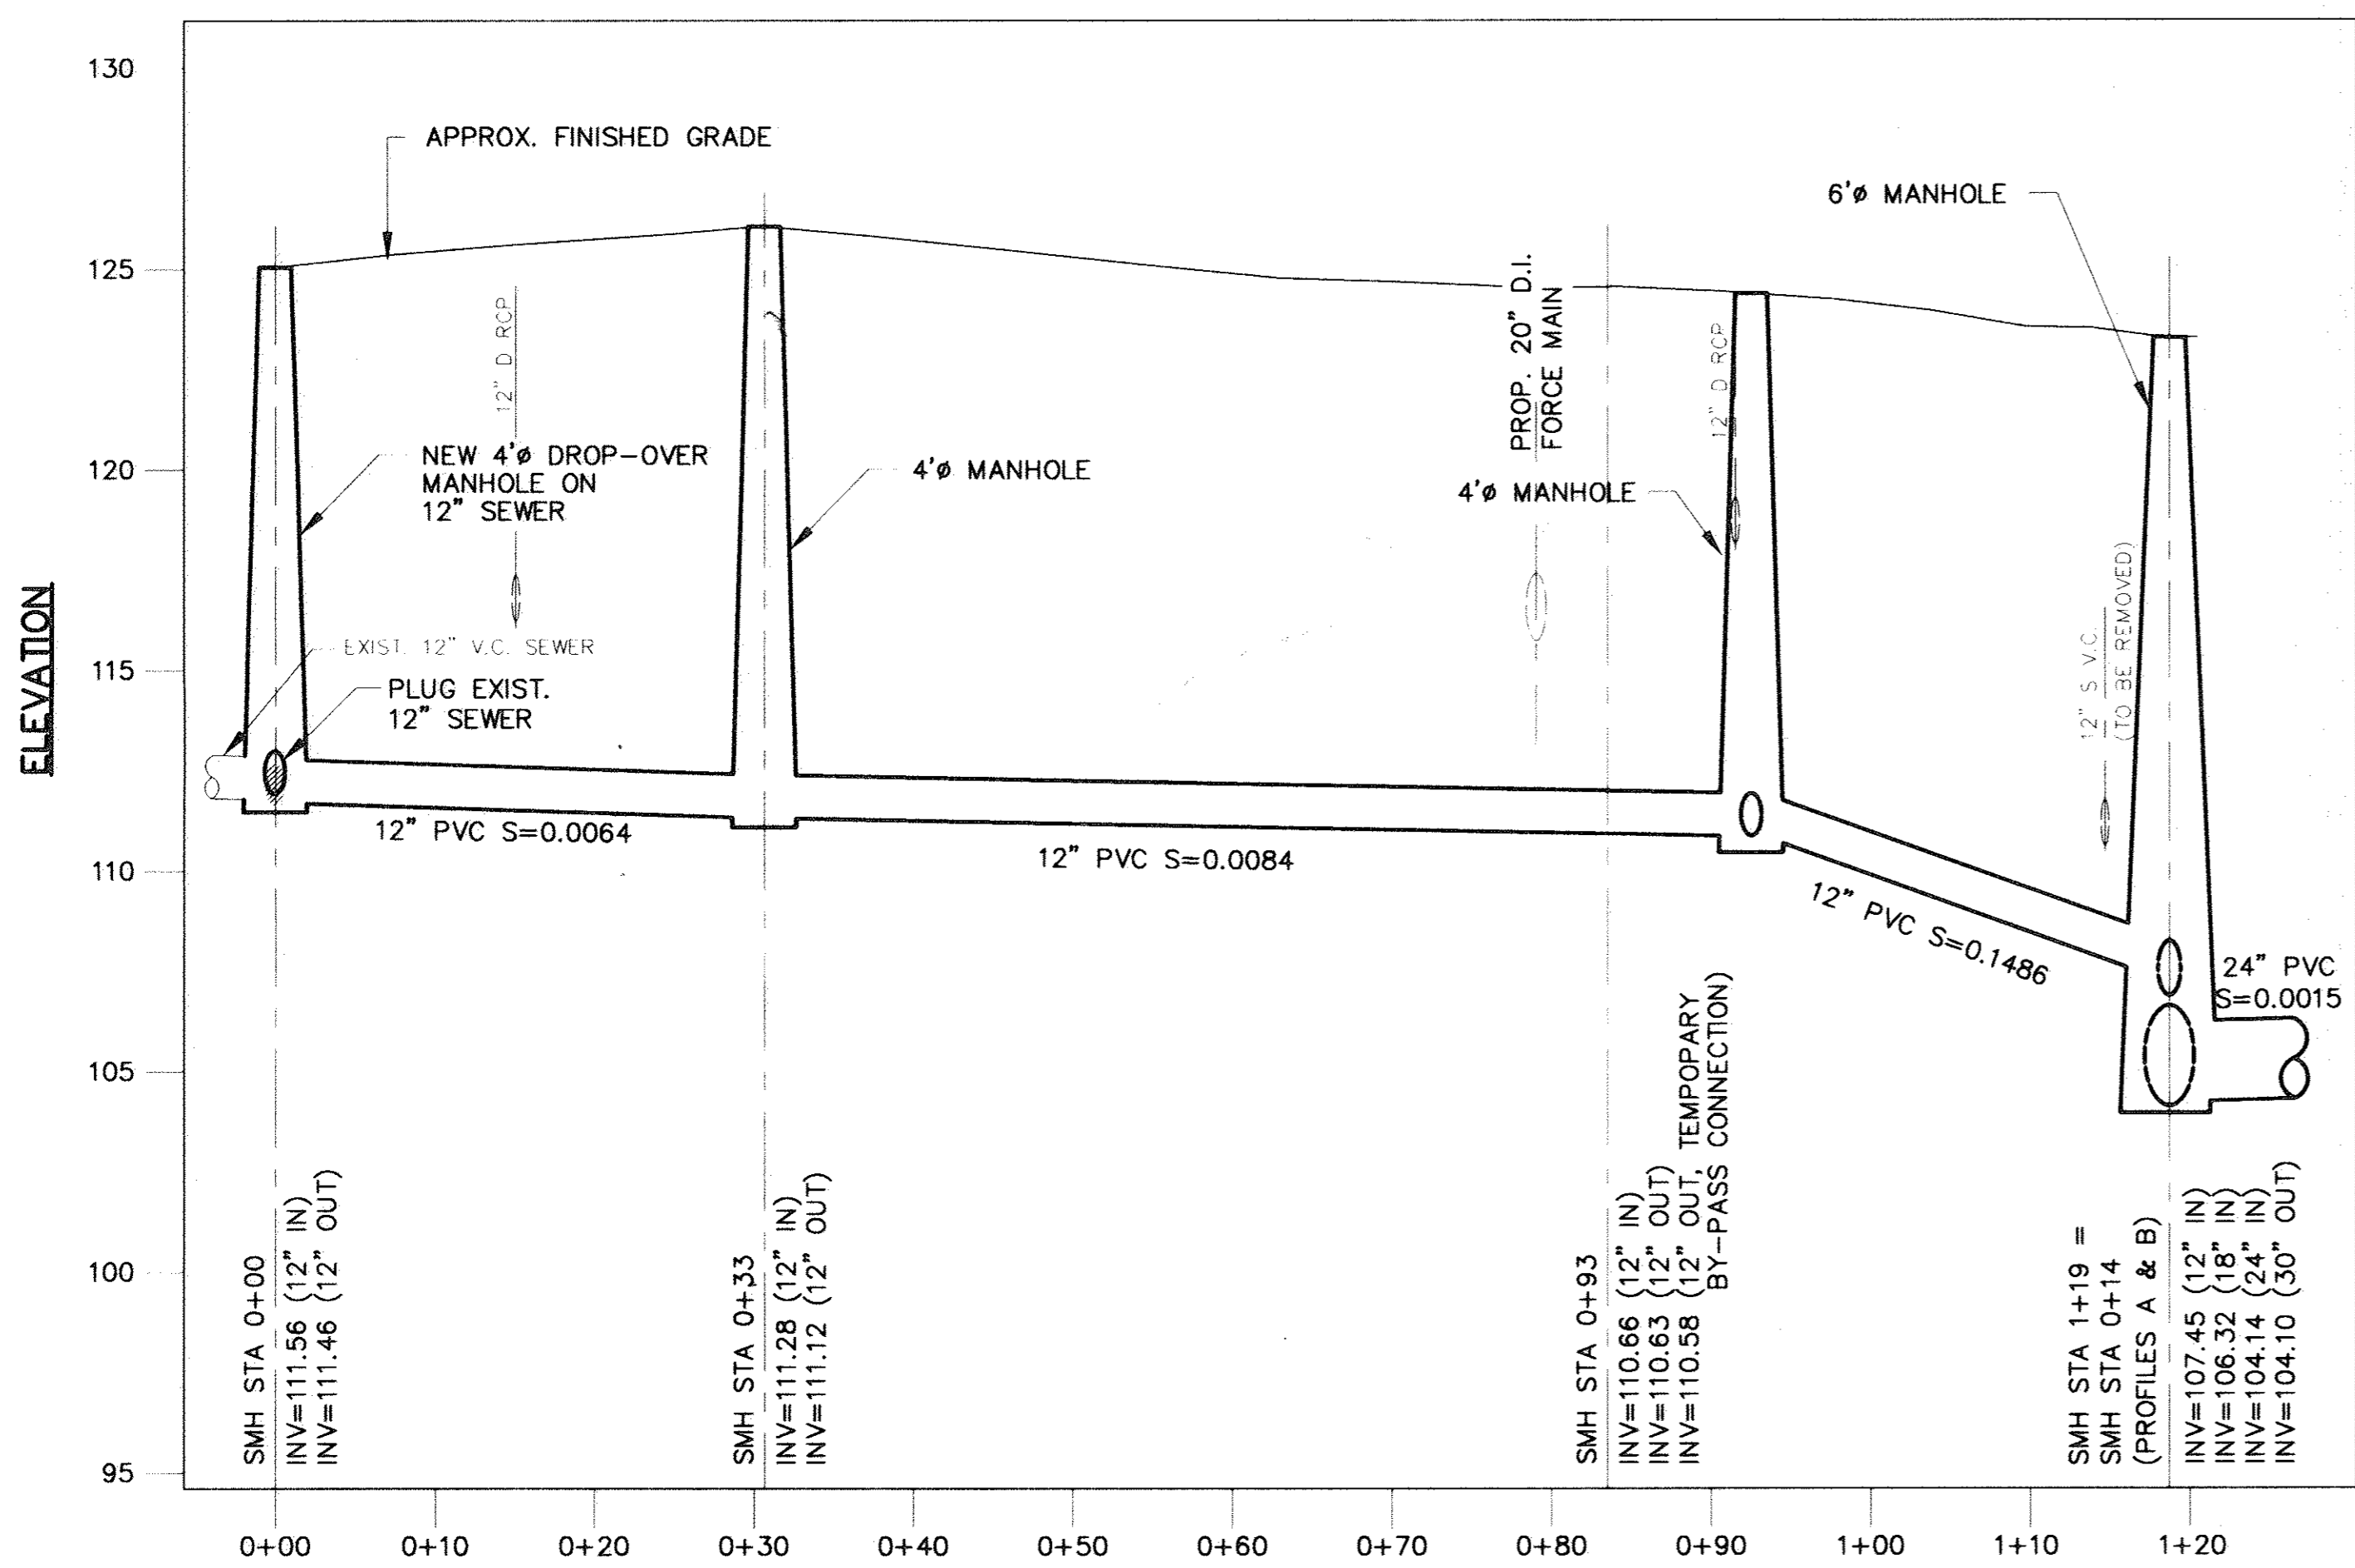

PROFILE C
SCALE: 1"=10' H
1"=4' V

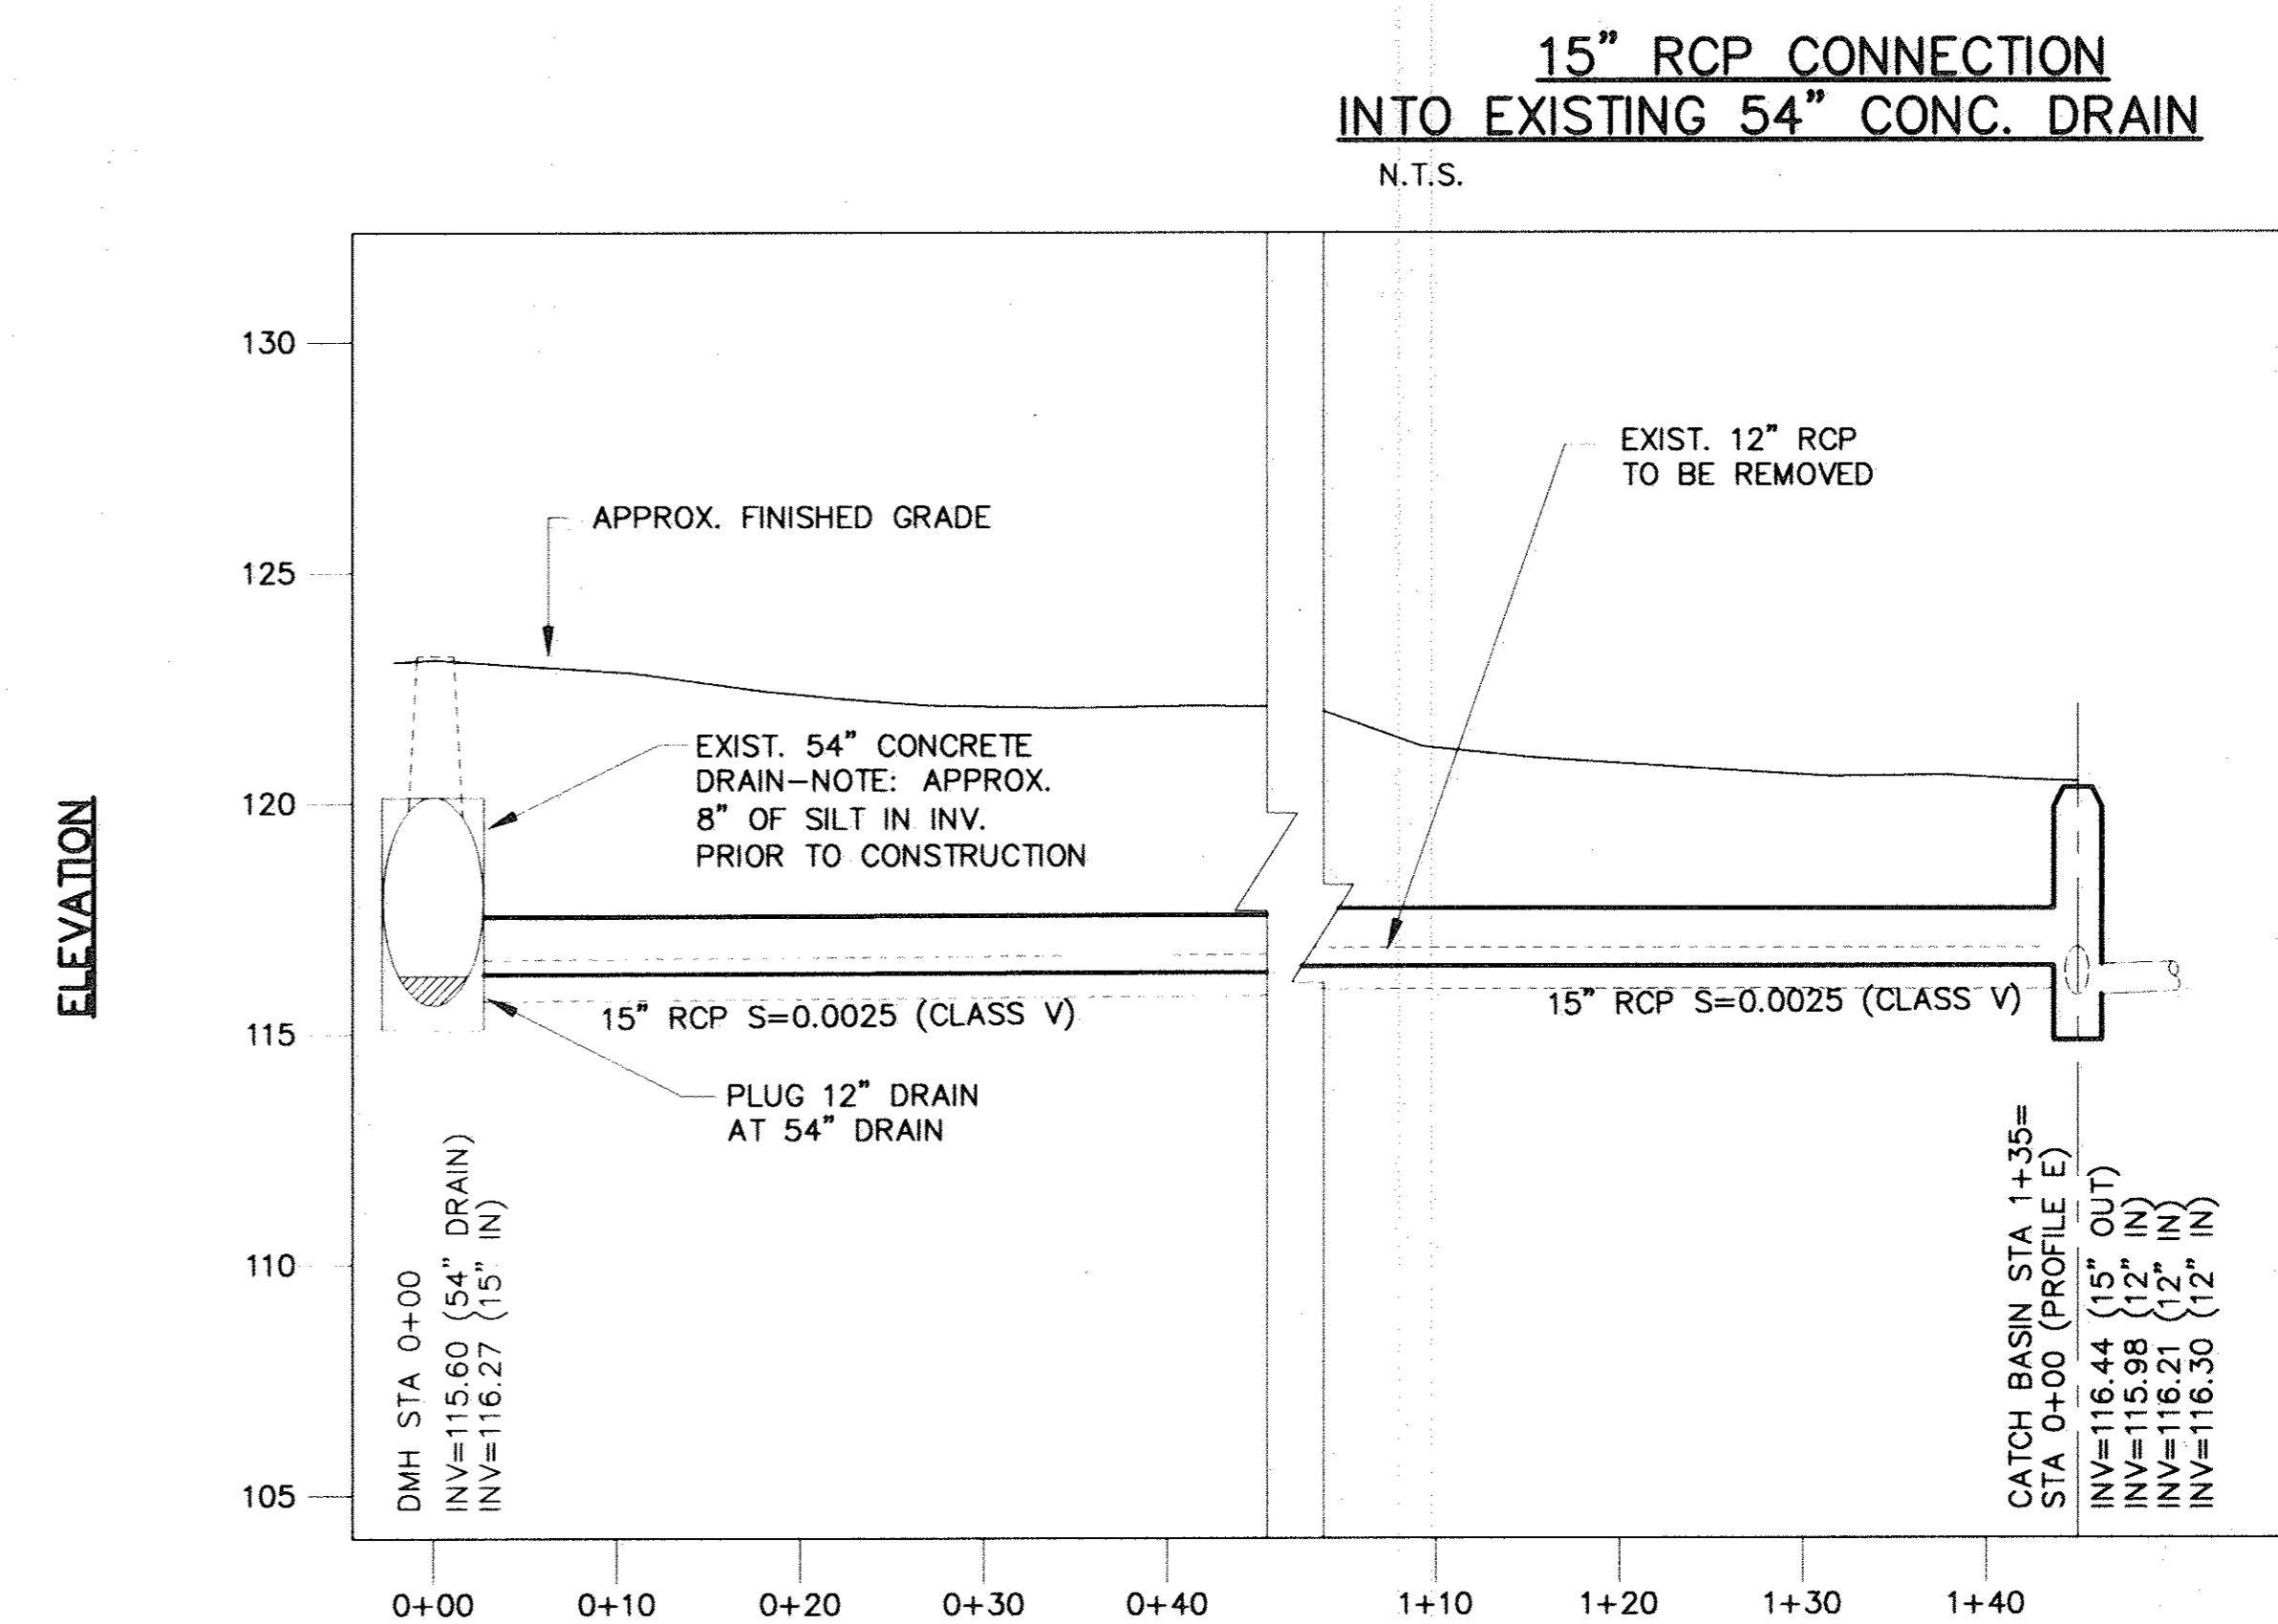

PROFILE D
SCALE: 1"=10' H
1"=4' V

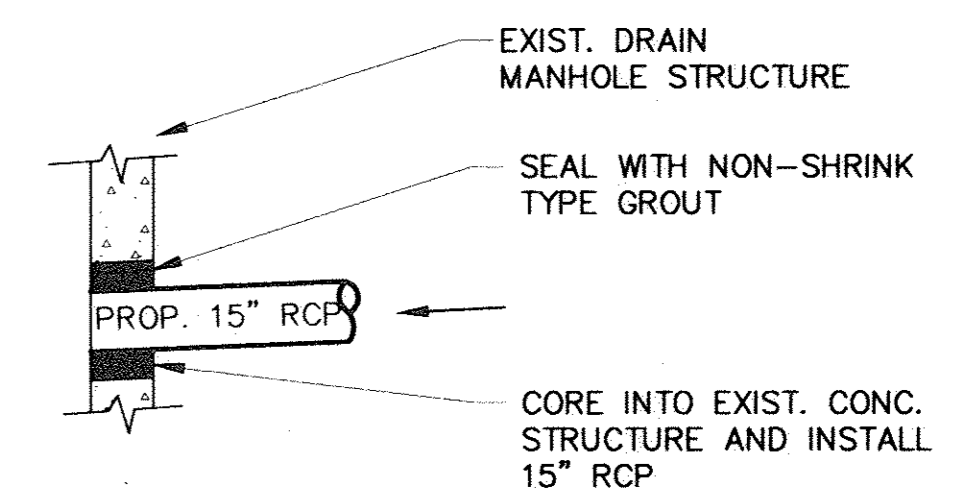


15" RCP CONNECTION INTO EXISTING 54" CONC. DRAIN
N.T.S.

REVISIONS			
No.	Date	Description	By
3	5/95	M.R.K. F.W.Y. REVISED FOR RECORD DRAWING	
2	3/92	M.L.M. P.M.S. GENERAL REVISIONS	
1	7/91	S.G.I. M.L.M. P.M.S. GENERAL REVISIONS	

A	P	R	O	V	E	D

REGISTERED PROFESSIONAL ENGINEER
Peter M. Sampson
DATE: 3/5/92

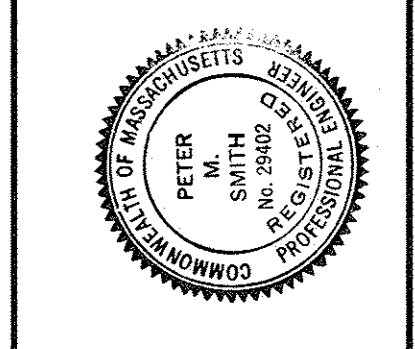

TOWN OF LEXINGTON, MASSACHUSETTS DEPARTMENT OF PUBLIC WORKS	JOB NO. 9065	APP. BY P.M.S.
NORTH LEXINGTON MAIN PUMPING STATION	CONTRACT 92-1	CHK. BY M.L.M.
SEWER AND DRAIN PIPE PROFILES	SCALE NOTED	DR. BY R.W.S.
CADD NO. RDET-1	NOTED	DATE 3/5/92

