



SECTION 1  
SCALE: 1/4" = 1'-0"

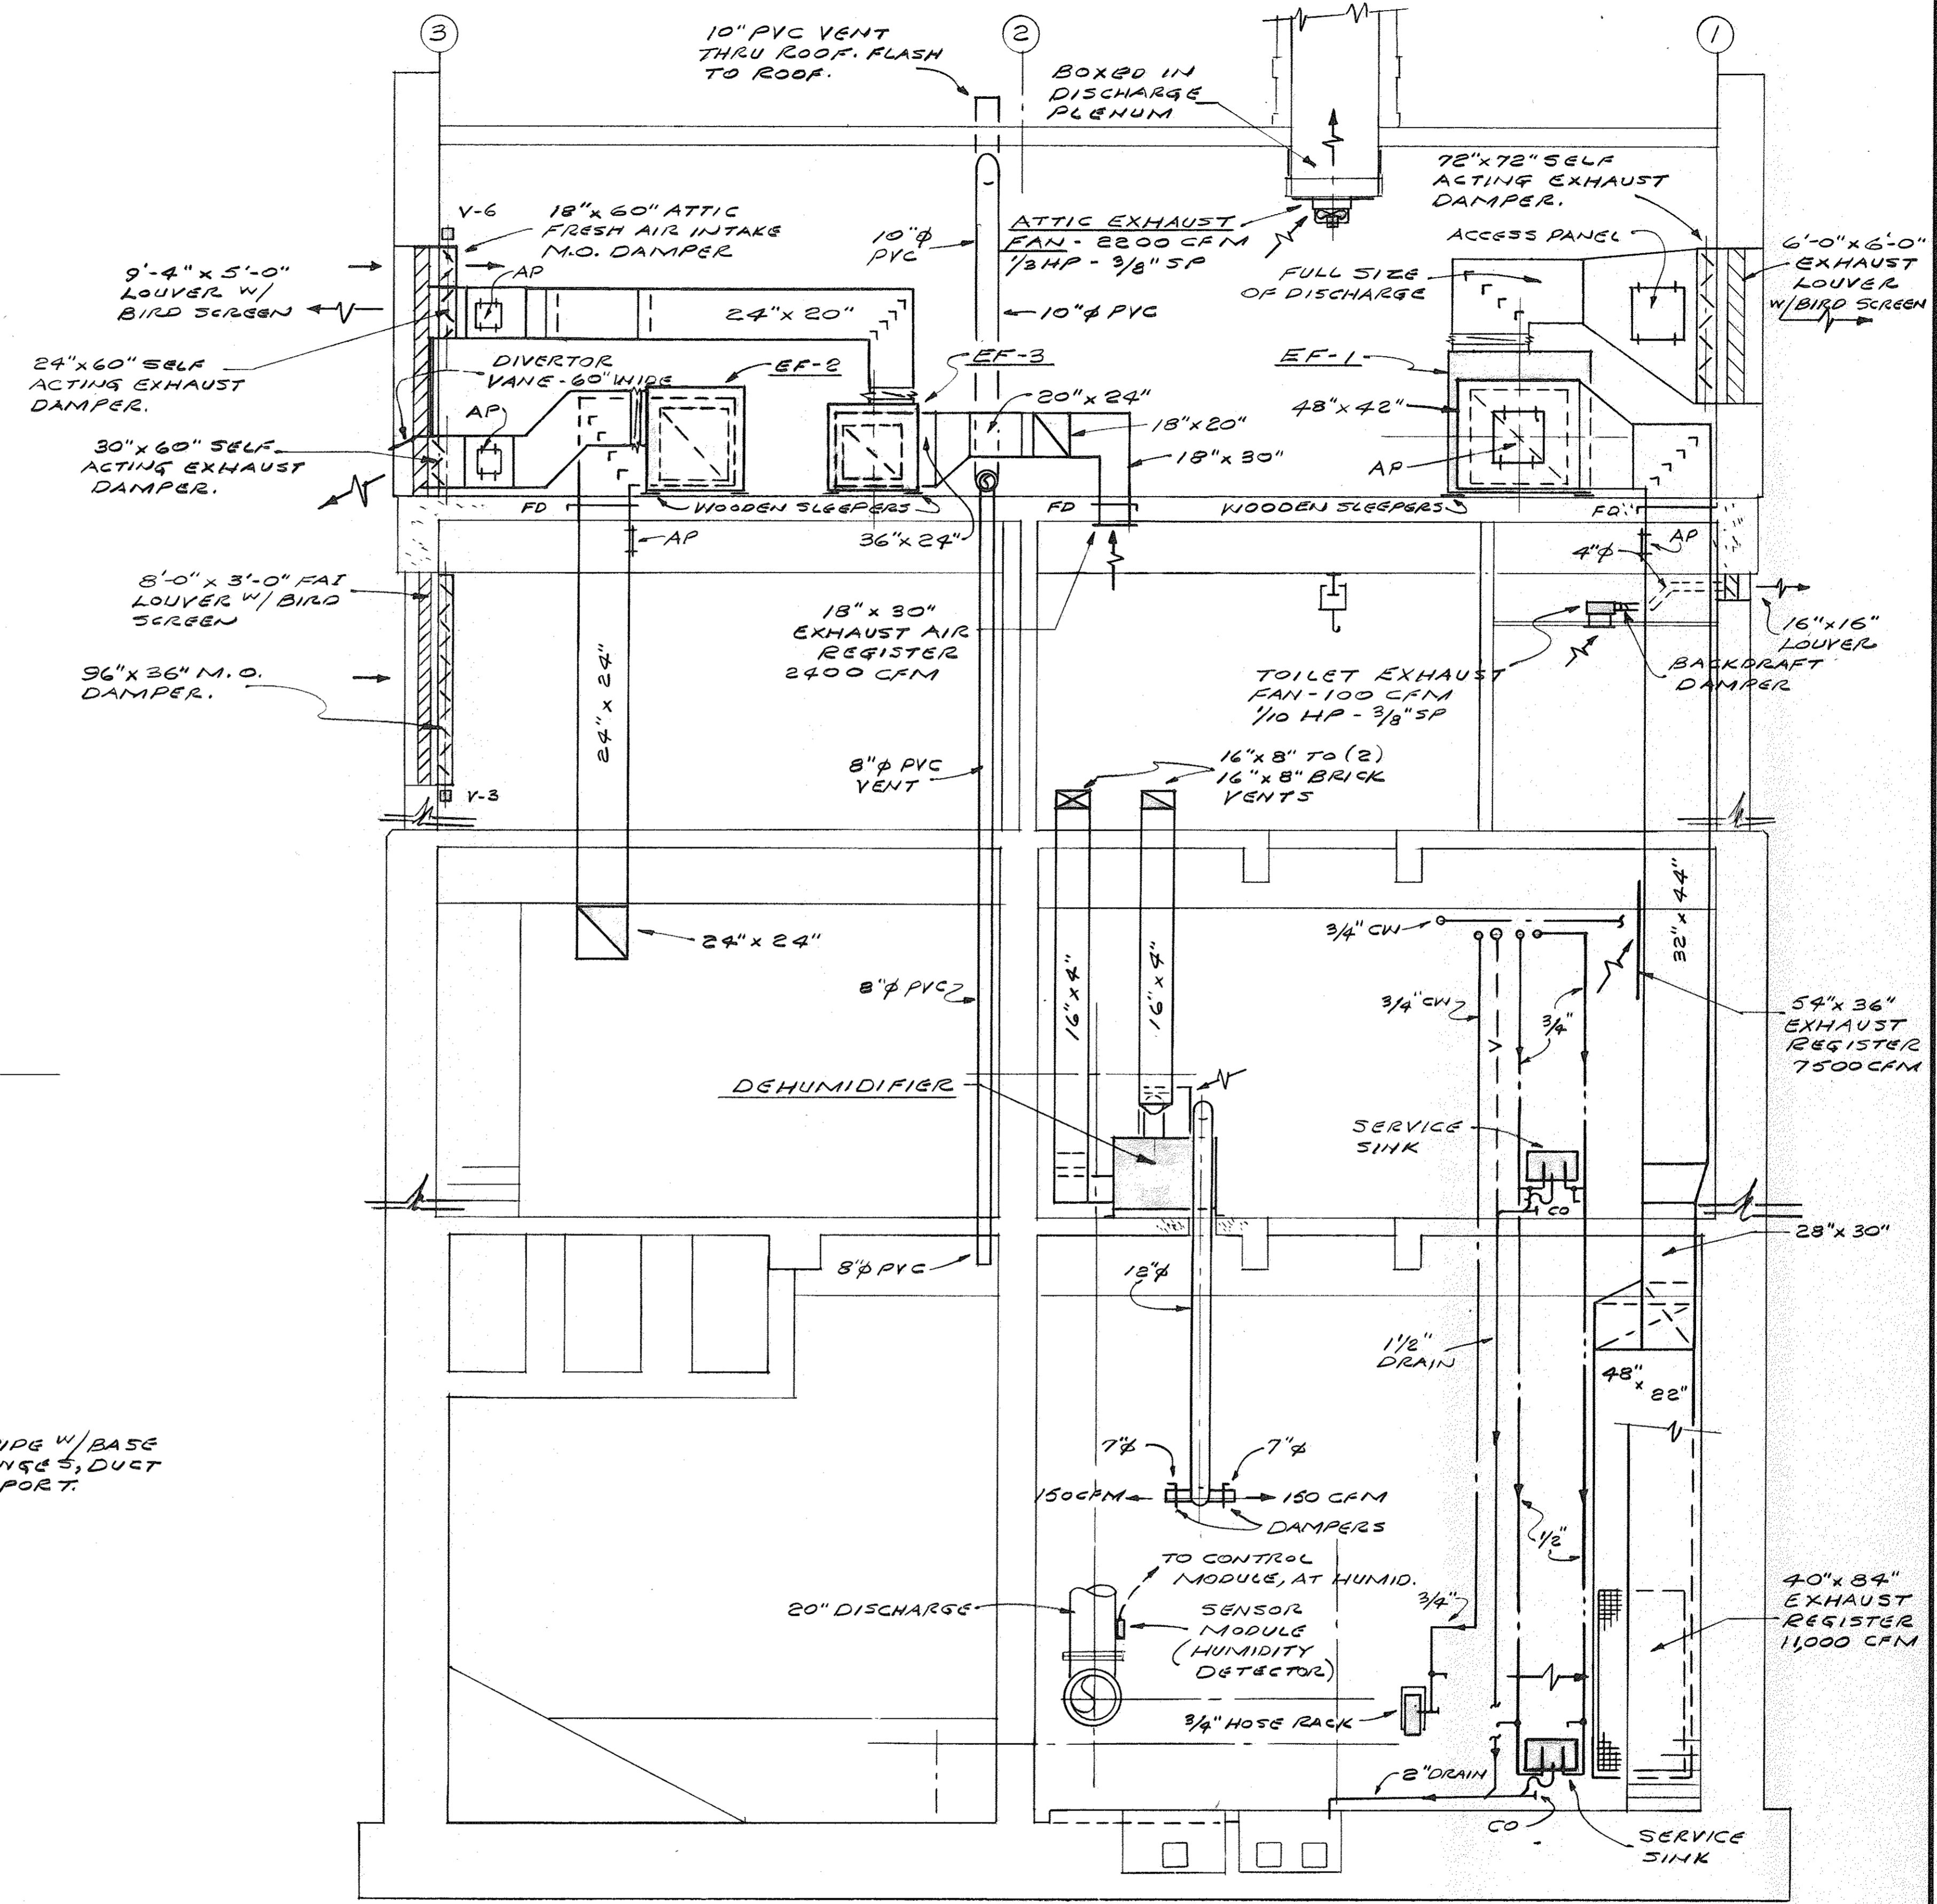

SECTION 2  
SCALE: 1/4" = 1'-0"

No.	1	5/95	RNS	MLM	FNY	RECORD DRAWING	Description	
Date								
Dr. By								
App. By								
Check								
Scale								
Job No.								
Contract								
Scale								
As Noted								
Job No.								
9065								
Dr. By								
EPF								
App. By								
SHC								
Date								
4/30/91								
Dr.								
REGISTERED PROFESSIONAL ENGINEER								

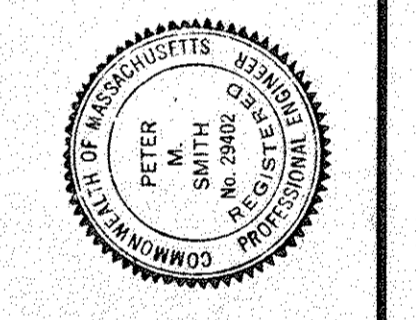

TOWN OF LEXINGTON, MASSACHUSETTS  
DEPARTMENT OF PUBLIC WORKS  
NORTH LEXINGTON MAIN PUMPING STATION  
**PLUMBING SECTIONS**

FILE NO. HVP-3  
69-24  
SHEET 41 OF 42