


SECTION 3
SCALE: 1/4"=1'-0" M-1,2

- NOTES:**
1. PROVIDE SAFETY HOOK IN WALL ADJACENT TO EACH HATCH AND CHANNEL OPENING TO WET WELL A AND B. SET HOOKS 3 FEET ABOVE FLOOR. PROVIDE LIFTING HOOK IN CEILING ABOVE EACH STOP PLANK.
 2. ALL WALL PENETRATIONS BETWEEN WET WELL AND DRY WELL SHALL BE SEALED GAS TIGHT.
 3. FOR STRUCTURAL DETAILS AND DIMENSIONS, SEE ARCHITECTURAL AND STRUCTURAL DRAWINGS.
 4. FOR WET WELL BUBBLER TUBE SETTINGS, SEE SPECIFICATIONS, SECTION 13621.

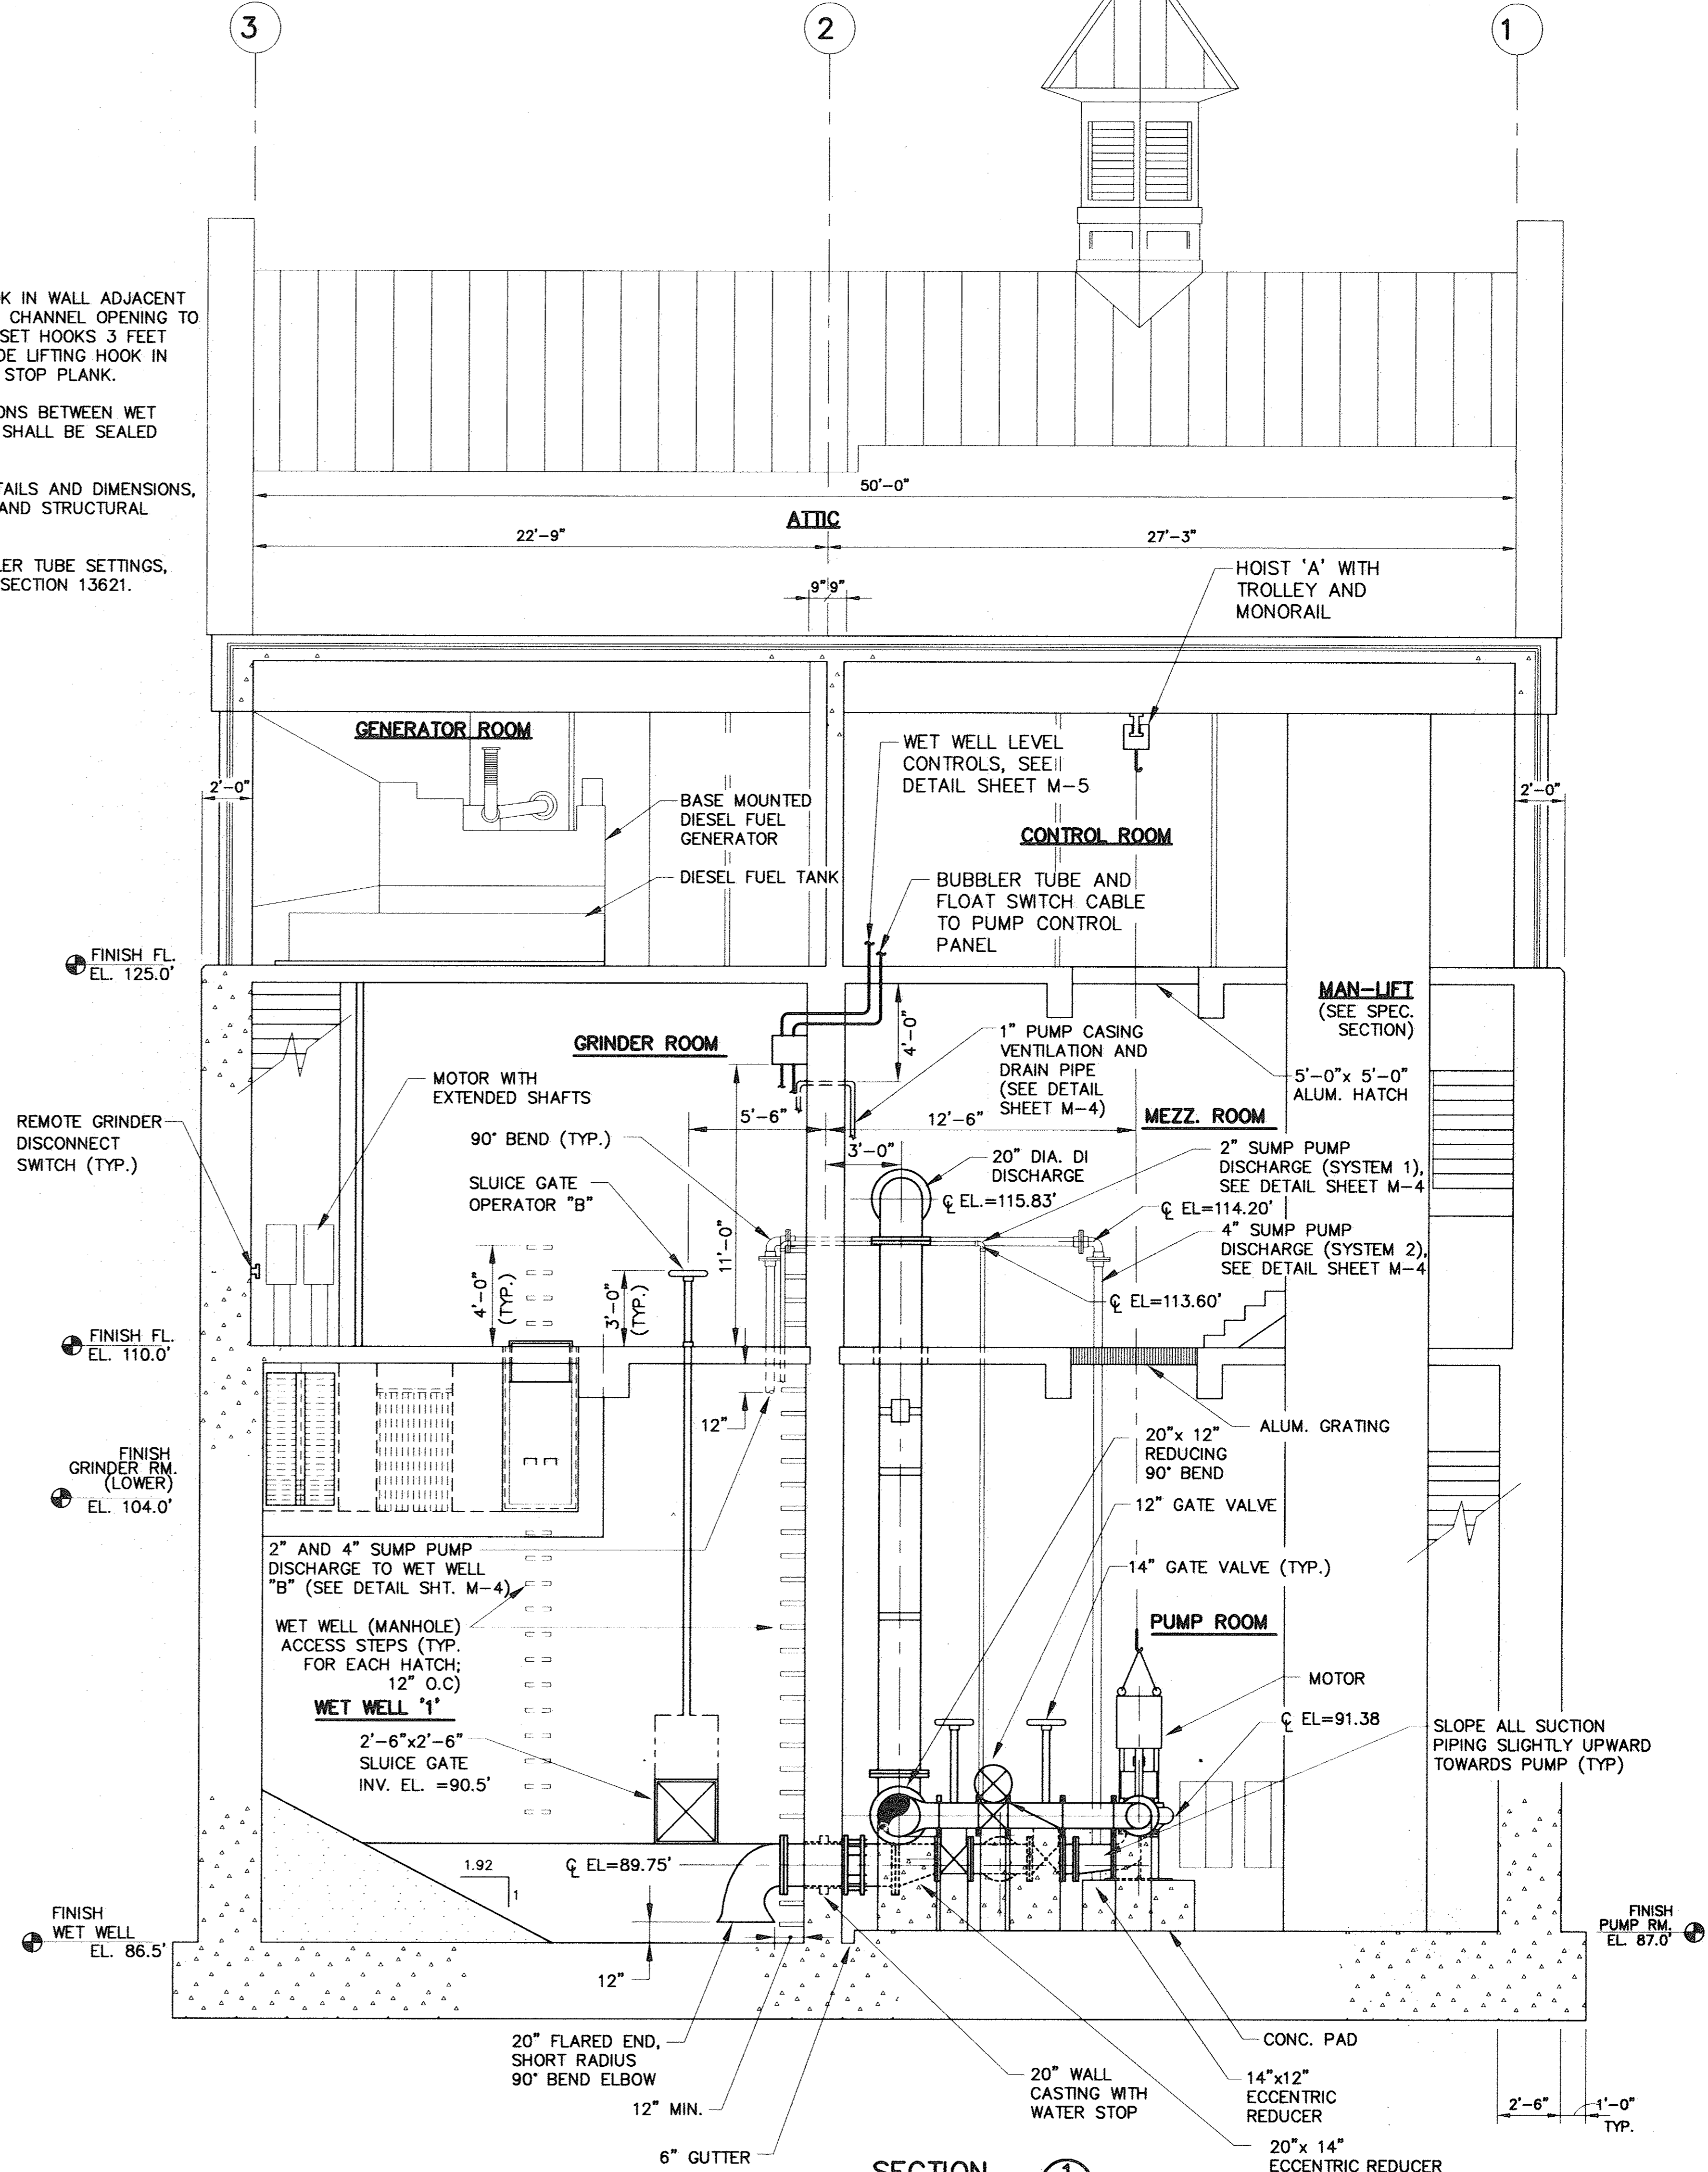

SECTION 1
SCALE: 1/4"=1'-0" M-1,2

RECORD DRAWING

Weston & Sampson ENGINEERS, INC.
Five Centennial Drive, Peabody, MA 01960-7985

2	5/95	M.R.K.	M.L.M.	F.W.Y.	REVISED FOR RECORD DRAWING
1	7/91	S.G.I.	M.L.M.	P.M.S.	GENERAL REVISIONS
No.		Date		Description	
A		P		R	
O		V		E	
D					

DATE: 1/15/92

REGISTERED PROFESSIONAL ENGINEER

TOWN OF LEXINGTON, MASSACHUSETTS
DEPARTMENT OF PUBLIC WORKS
NORTH LEXINGTON MAIN PUMPING STATION

SECTIONS

CADD NO. RNL-M-3
CONTRACT: 92-1
SCALE: NOTED
JOB NO. 9065
DATE: 1/15/92

M-3

FILE NO. 69-37

SHEET 28 OF 42