


SECTION 1
SCALE: 1" = 1'-0"

FILE NO.	69-43
DATE	11/07/92
REGISTERED PROFESSIONAL ENGINEER	<i>Peter M. Smith</i>
DESCRIPTION	RECORD DRAWING
APPROVED	A P P R O V E D
DATE	11/07/92
BY	Dr. By
CHECKED	Ck. By
DATE	Date
NO.	No.
REVISED	RW/S
MLM	MLM
DATE	Date

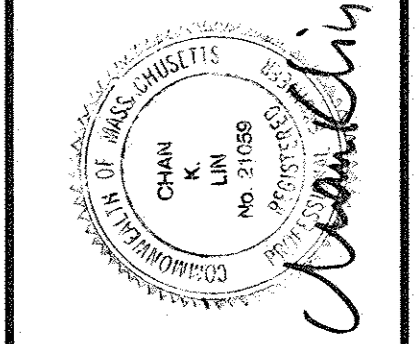

TOWN OF LEXINGTON, MASSACHUSETTS	CONTRACT NO.	92-1
DEPARTMENT OF PUBLIC WORKS	CONTRACT	AS NOTED
NORTH LEXINGTON MAIN PUMPING STATION	SCALE	AS NOTED
EAST ELEVATION	DATE	11/07/92
DESIGNED BY	WVS	
CHECKED BY	JRL	
APPROVED BY	RSJ	
JOB NO.	9065	
DATE	11/07/92	
SCALE	AS NOTED	
CONTRACT	92-1	
DATE	11/07/92	

S-6