



DETAIL (A)
NOT TO SCALE

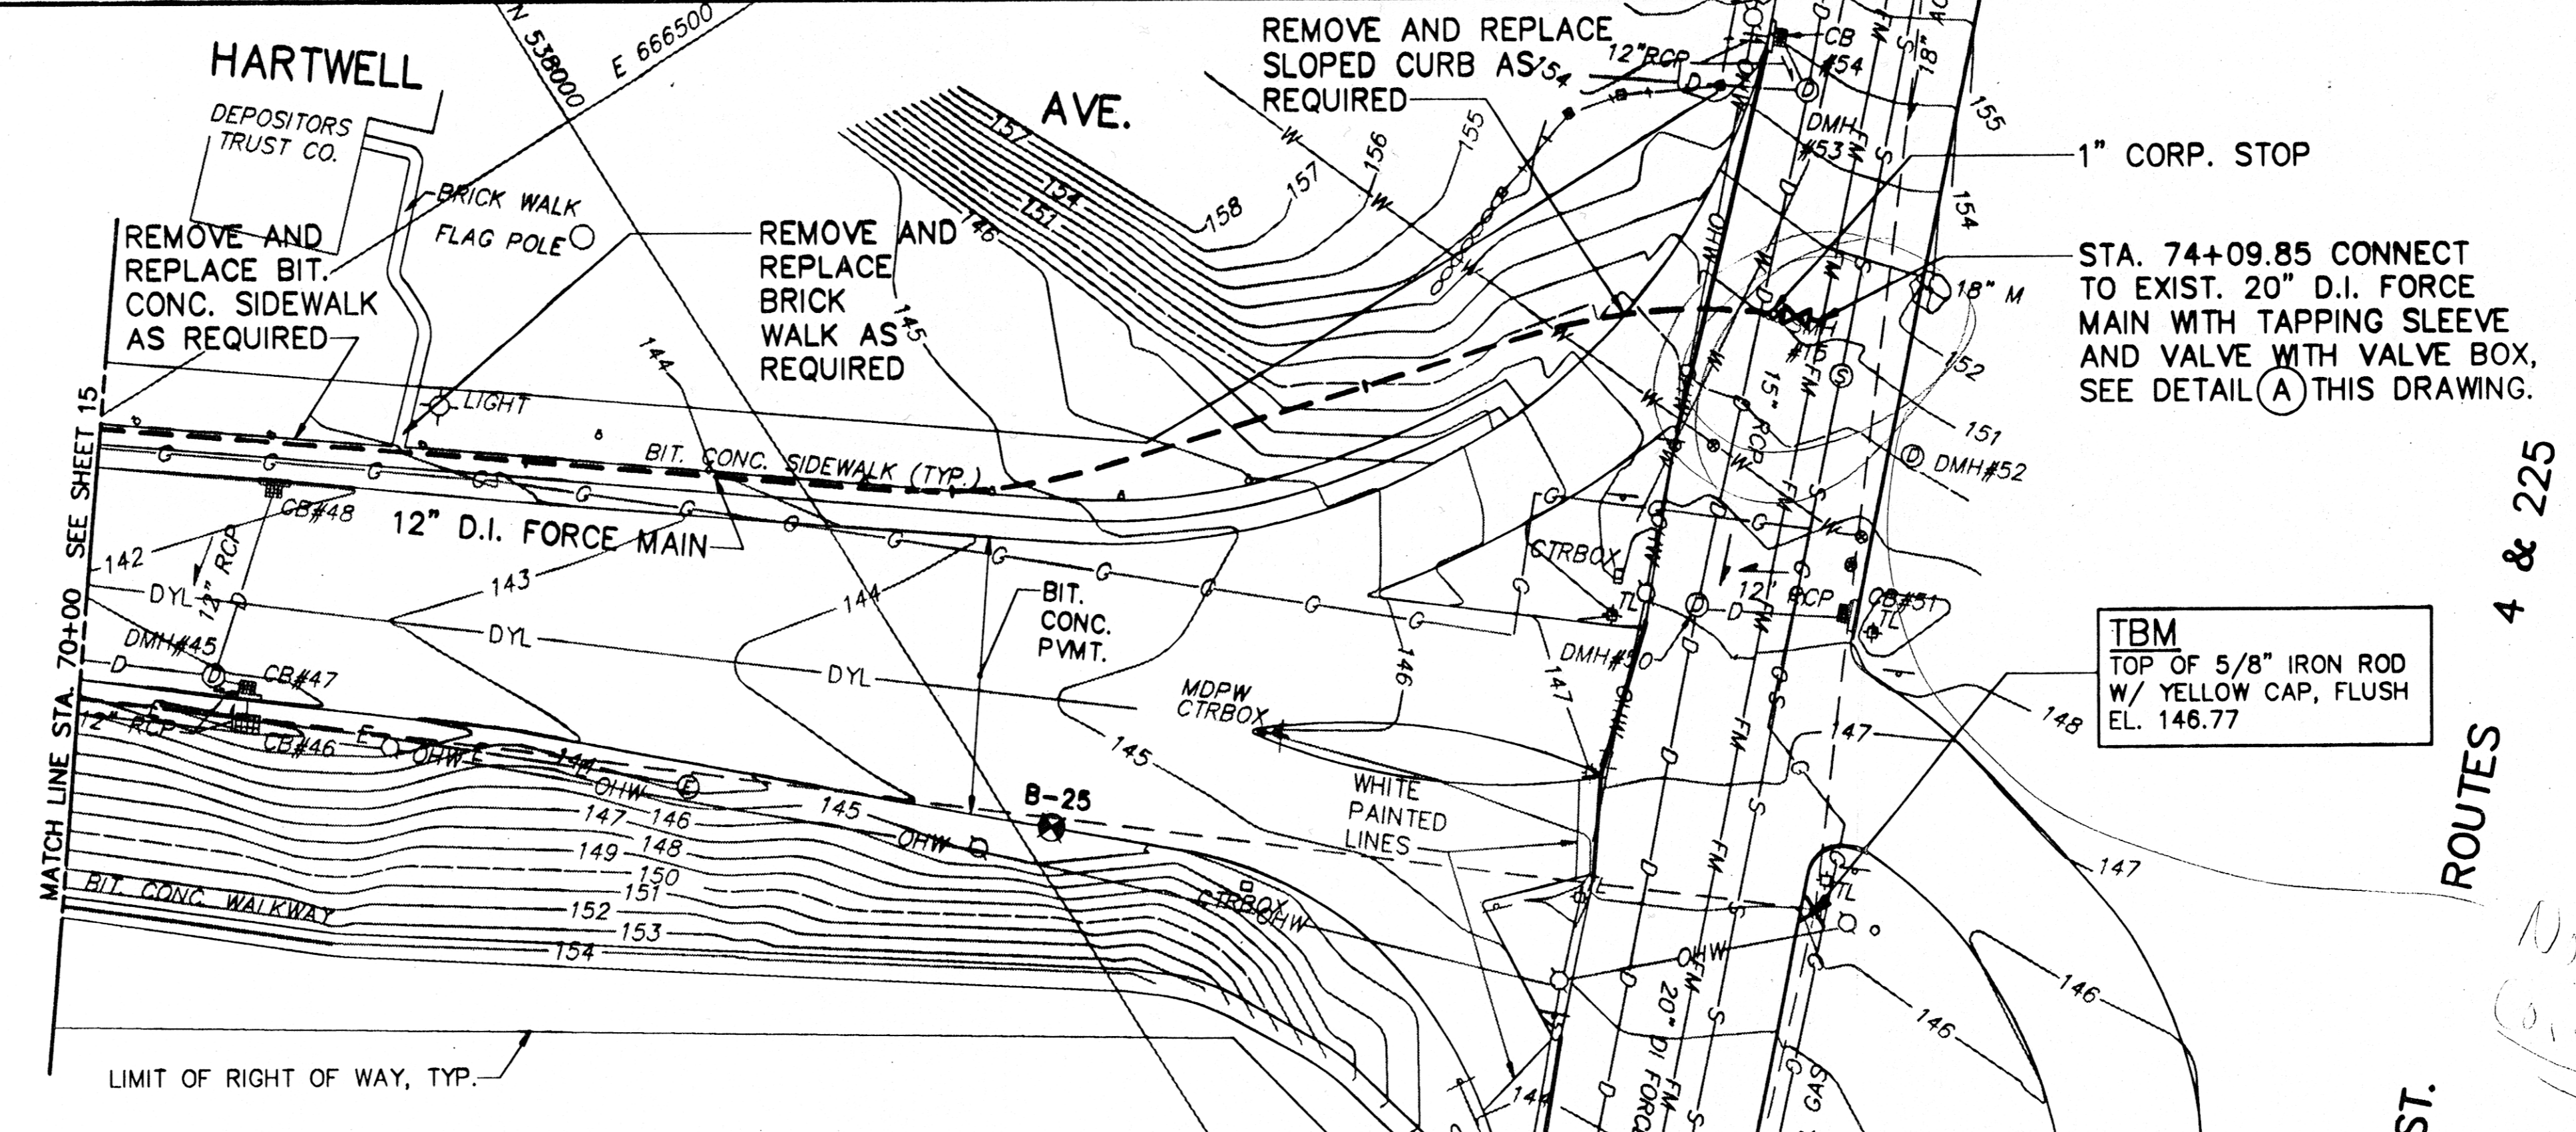

PLAN
SCALE: 1"=30'

LIMIT OF PAVEMENT OVERLAY,
SEE "KEYWAY DETAIL" DRAWING
NO. C-16, TYP.

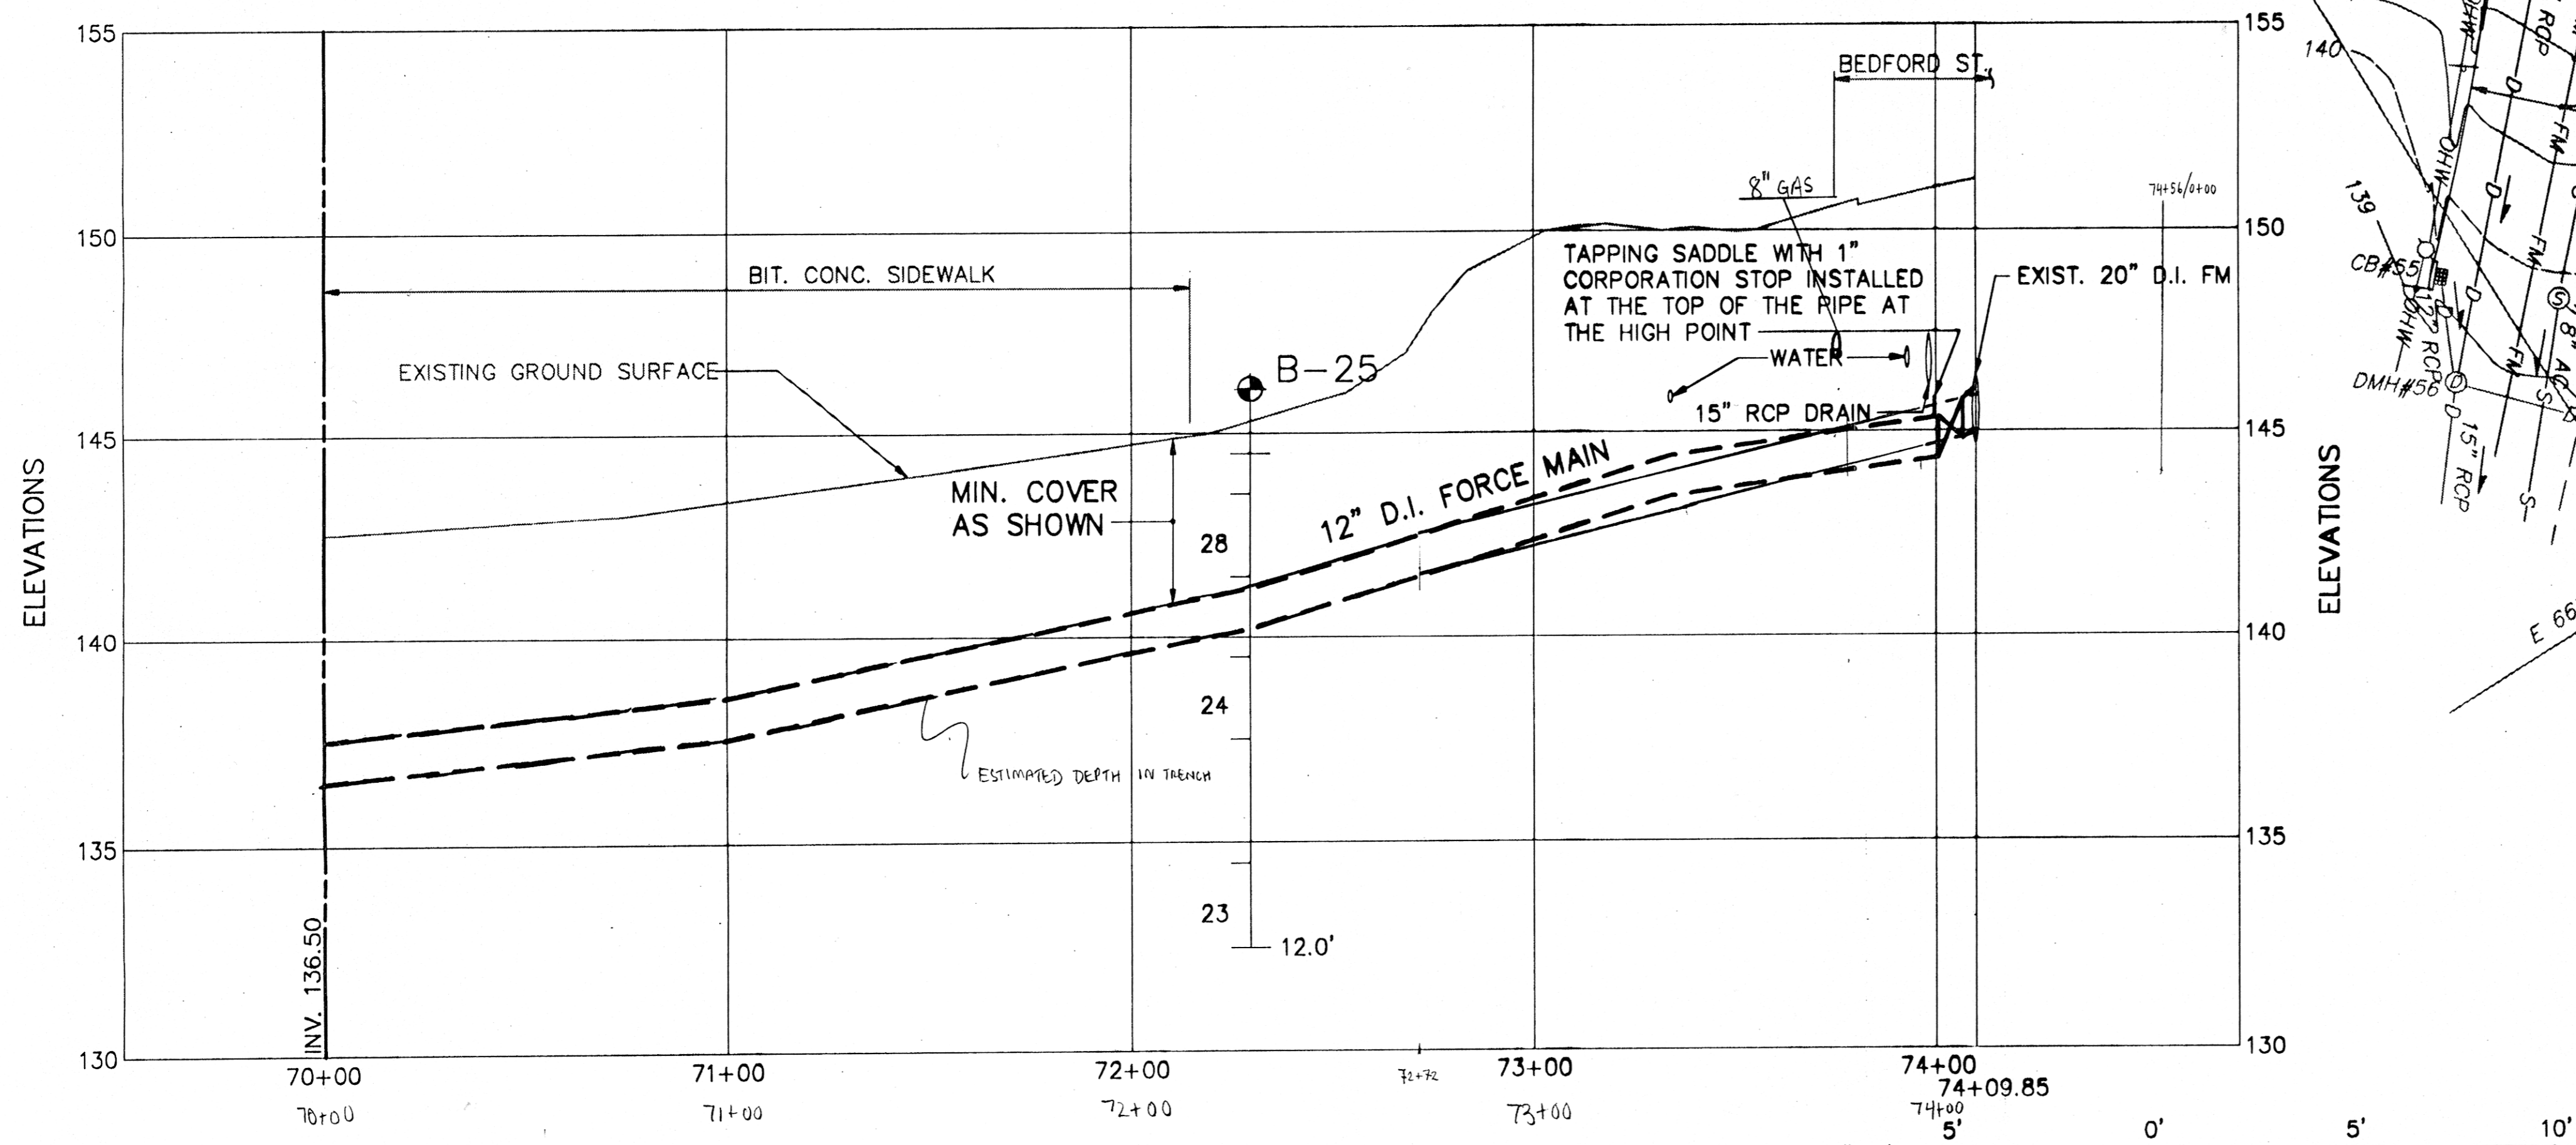

PROFILE
SCALE: HORIZ. 1"=30'
VERT. 1"=3'

NOTE:
WORK OF CONNECTION OF
EXISTING FORCE MAIN IN
BEDFORD ST. IS TO BE
PERFORMED DURING LOWEST
TRAFFIC PERIOD, BETWEEN
11:00PM AND 6:00AM.
WORK PRIOR TO 7:00AM
REQUIRES VARIANCE TO BE
OBTAINED FROM TOWN
MANAGER.

Not connect
Show correct pipe path
Note Loft
Hand turn on
E 667000
valve

 FAY, SPOFFORD & THORNDIKE, INC. LEXINGTON, MA COORDINATION	REV	DATE	DESCRIPTION	DRAWN	APP'D
	DEPARTMENT OF THE AIR FORCE 847 SPTG / CECE HANSCOM AFB, MA. 01731 BASE CIVIL ENGINEERING SQUADRON				
	REPAIR SEWER FORCE MAIN HANSCOM AIR FORCE BASE, MA. STA. 70+00 TO BEDFORD STREET				
	DRAWING NO.: C-10 CIVIL				
SAFETY	SECURITY	COMMUNICATIONS	FIRE CHIEF	MEDICAL SERVICES	USING AGENCY
CHIEF, O&M	CONTRACT PROGRAM.	CONSTRUCTION MGT	CORROSION CTRL.	ENVIRONMENTAL	ENERGY CONSERV.
CHIEF, ENGRG. SECT.	CHIEF, ENGRG. & ENV PLNG BR	ARCHITECT	CIVIL ENGINEER	ELECTRICAL ENGR	STRUCTURAL ENGR
DATE	SCALE	AS NOTED	PROJECT NUMBER	DRAWN BY CAP/CAO/DBR	
12 AUGUST 1993	AS NOTED	MXRD92-0035		VAULT FILE NUMBER	
			SHEET 16 OF 31		