

Name

Service No.

Address 7 ABBOTT RD

Location

Kind of Pipe PVC

Size

6"

Size of Main

8"

Repair—Renewal (New Service)

Location

Date

Material

Amount

Total

Date

Amount

2/2 89


78' 6" PVC
22° BEND

~~REDUCER~~ Ferroc 6" x 4"
SADDLE (STACK 2 1/2') CLEAR OUT

DATE _____

TOWN OF LEXINGTON — BOARD OF PUBLIC WORKS
SEWER DIVISION

Sketch of Service Here

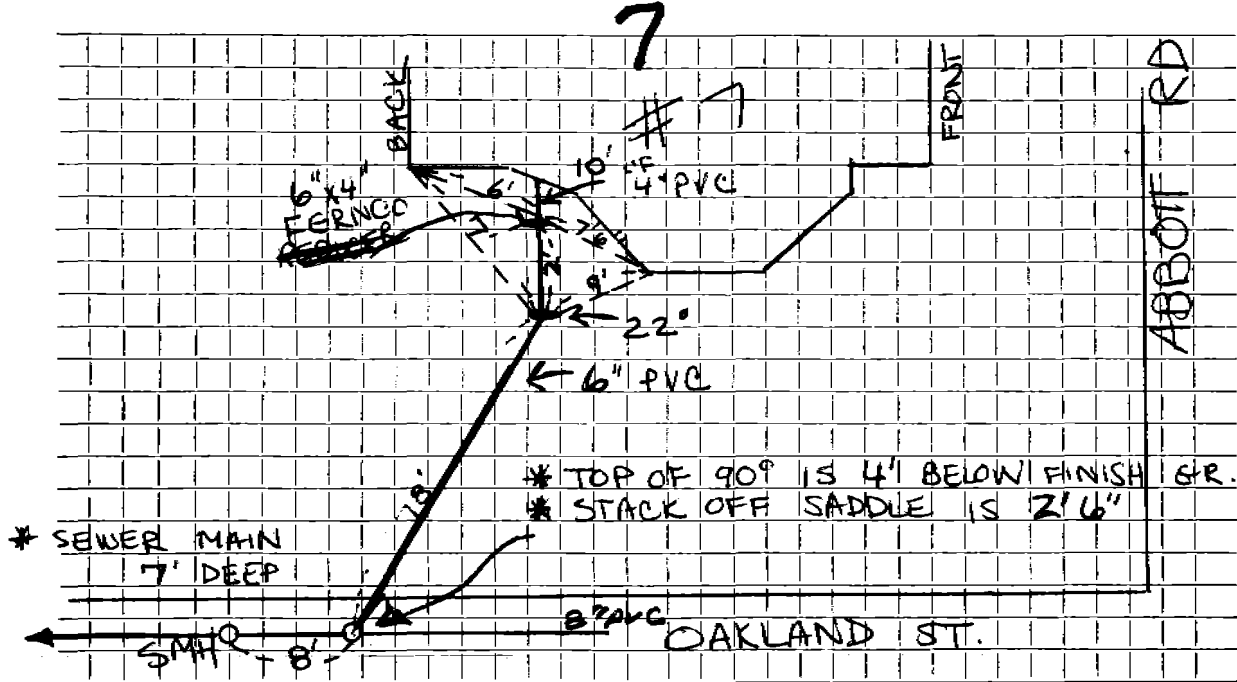

Connection made in Street. Work completed

Remarks:
.....
.....