

Name Fesco Builders

Service No. 47

Address 2 Abernathy Road

Location

Kind of Pipe

Size

Size of Main

~~Repair - Renewal~~ - New Service *VO # 8673*

Location JUN 29 1964

Date	Material	Amount	Total	Date	Amount
5/21/64	Labor	20 19		4-9-64	100 00
	10% O.H.	2 02	22 21	6-29-64	8 71
	100' 6" Transite Pipe @ .82		82 00		108 71
	1 Bag Cement		1 50		
	1 Hr. Trucking @ 3.00		3 00		
			<u>108 71</u>		

DATE _____


TOWN OF LEXINGTON — BOARD OF PUBLIC WORKS

SEWER DIVISION

2 ABERNATHY RD

~~30~~ 30000125

Sketch of Service Here

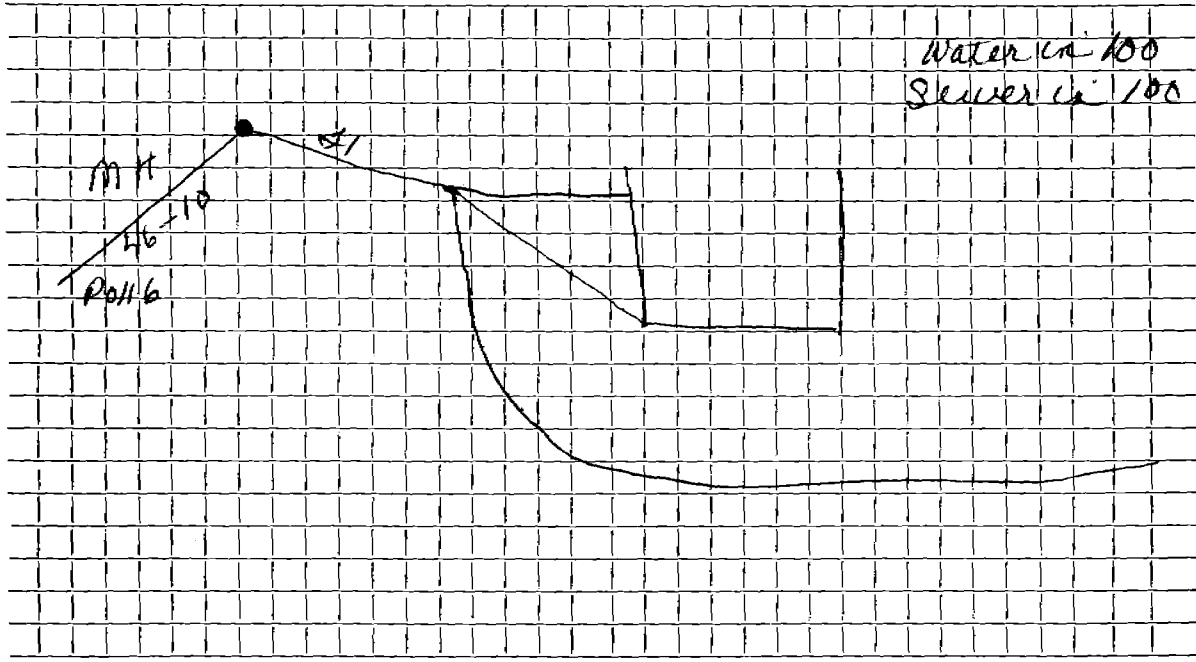

Connection made in Street. Work completed

Remarks:
.....
.....