

Name **Esco Builders Corp.**

Service No. **172**

Address **6 Abernathy Road**

Location

Kind of Pipe

Size

Size of Main

~~Repair - Renewal~~ **New Service** W.O. #8293

Location **MAR 23 1964**

Date	Material	Amount	Total	Date	Amount
11/12/63	Labor	50 74		11-6-63	100 00
	10% overhead	5 07	55 81	3-23-64	28
35'	6" Transite pipe @ .82		28 70		99 72
1	1 1/4" Transite Bend		4 09		
1	6" Adapter		1 62	12-26-64	RESPOND AND MEASURE
1	hr. Town Shovel		6 50		
1	hr. Trucking		3 00		
			99.72		


DATE _____

TOWN OF LEXINGTON — BOARD OF PUBLIC WORKS

SEWER DIVISION

Sketch of Service Here

6 ABERNATHY
30000 132

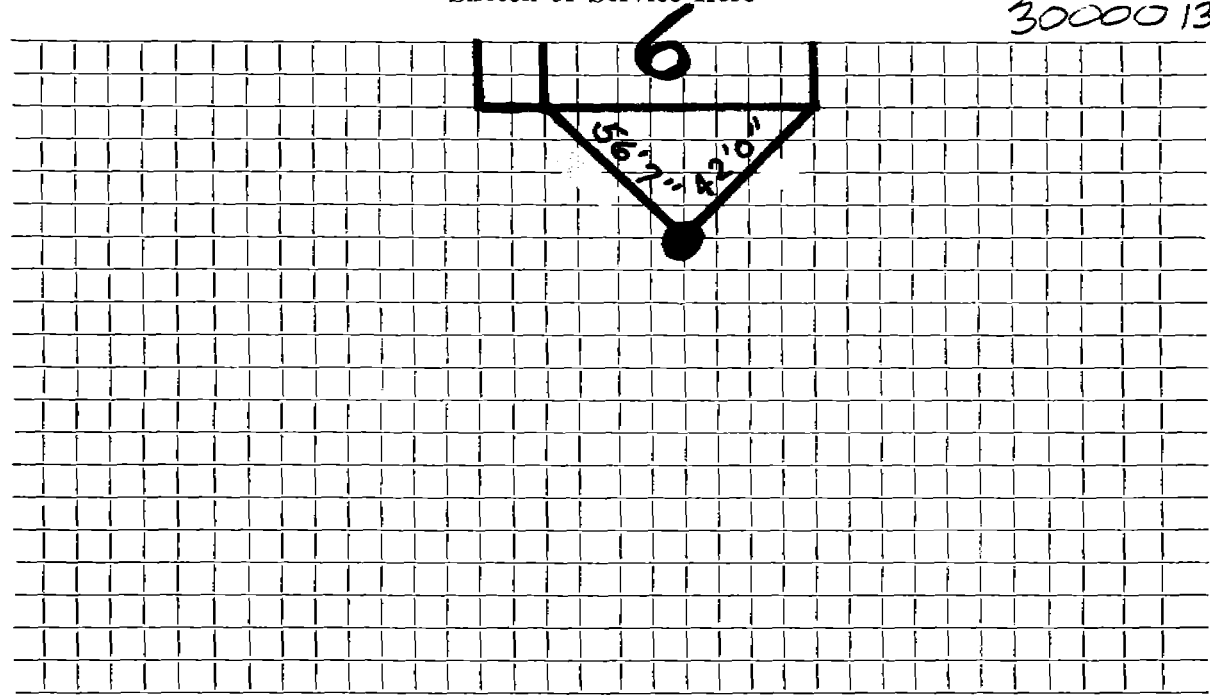

Connection made in Street. Work completed

Remarks:
.....
.....