




DATE \_\_\_\_\_

TOWN OF LEXINGTON — BOARD OF PUBLIC WORKS

SEWER DIVISION

Sketch of Service Here

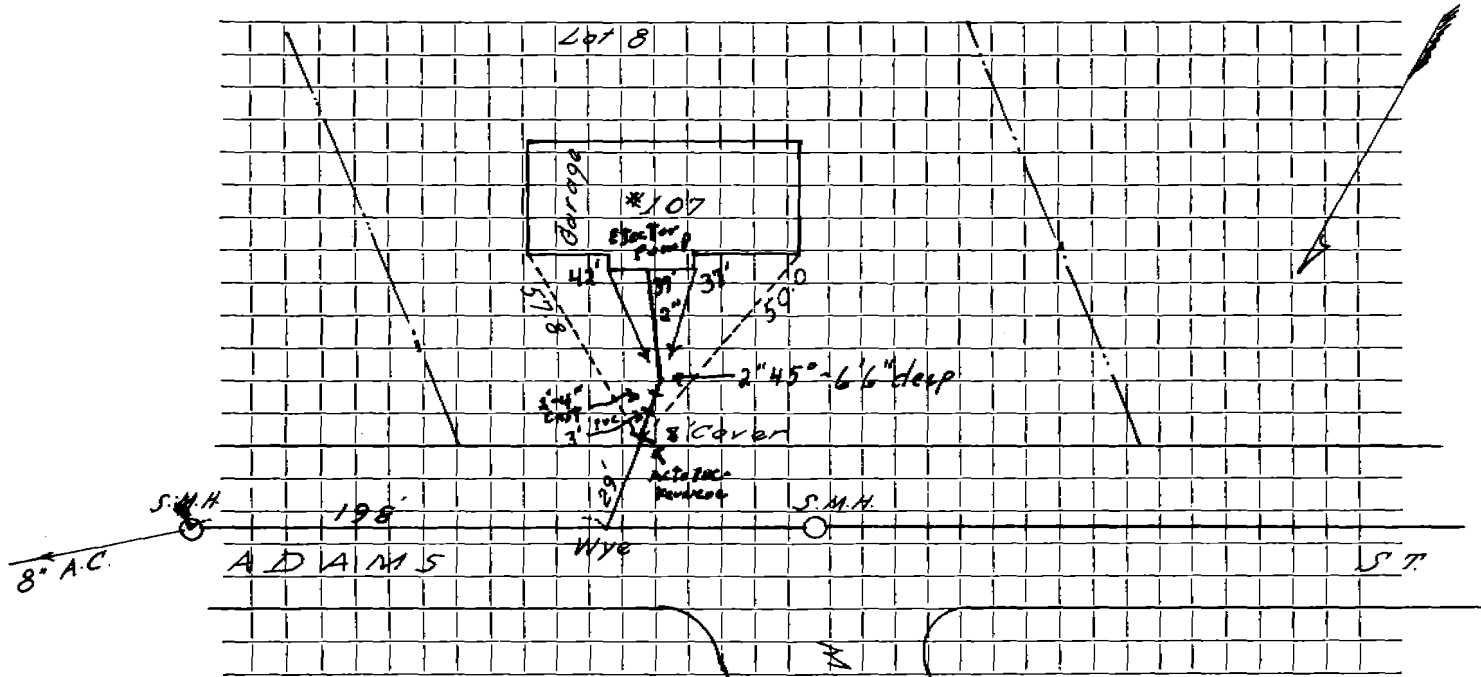

Connection made in \_\_\_\_\_ Street \_\_\_\_\_ Work completed \_\_\_\_\_

Remarks: Ejector Pump in house pumped up to 45° \_\_\_\_\_

... from 45° out to main is Gravity feed \_\_\_\_\_

2" vent at house \_\_\_\_\_

MILLBROOK RD