


TOWN OF LEXINGTON



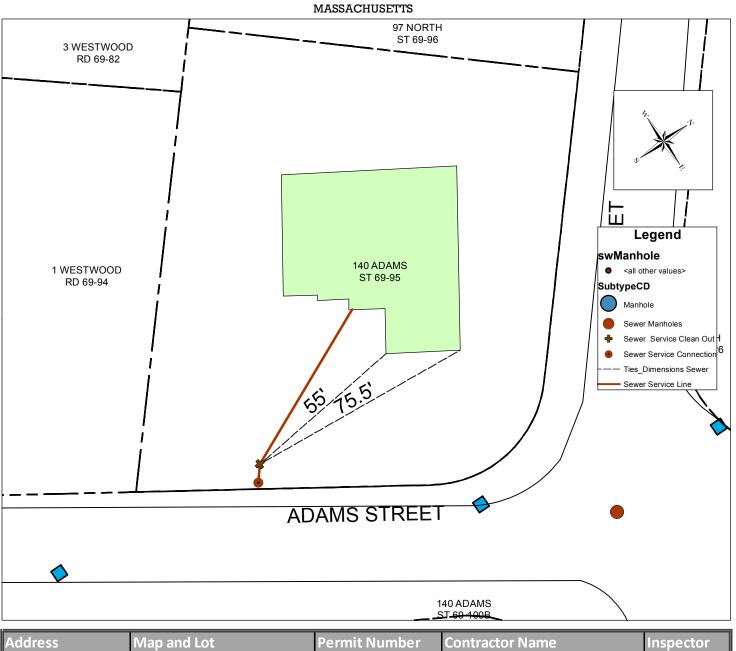

Address	Map and Lot	Permit Number	Contractor Name	Inspector
140 Adams St	69-95	6339	McLaughlin, James M. Inc.	msprague
Date	Material	Depth of Cover	Amount	
8/17/2015	6x6 AC to PVC Fern Co	4 ft	1-Connect to existing stub	
	6" PVC Clean out		1	
	6" PVC Pipe - SDR 35		55 ft to Fernco	
Type of work completed				

New 6" PVC sewer service installed to new house, connection to existing stub.