

Name

Service No.

Address #147 ADAMS ST

Location

Kind of Pipe A.C.

Size 6"

Size of Main 8

Repair—Renewal—New Service

Location


Date	Material	Amount	Total	Date	Amount
2/29/73	23'- A.C. @ 8.90	204.70			
"	28'- A.C. @ 8.90	249.20			

DATE _____

TOWN OF LEXINGTON — BOARD OF PUBLIC WORKS

SEWER DIVISION

Sketch of Service Here

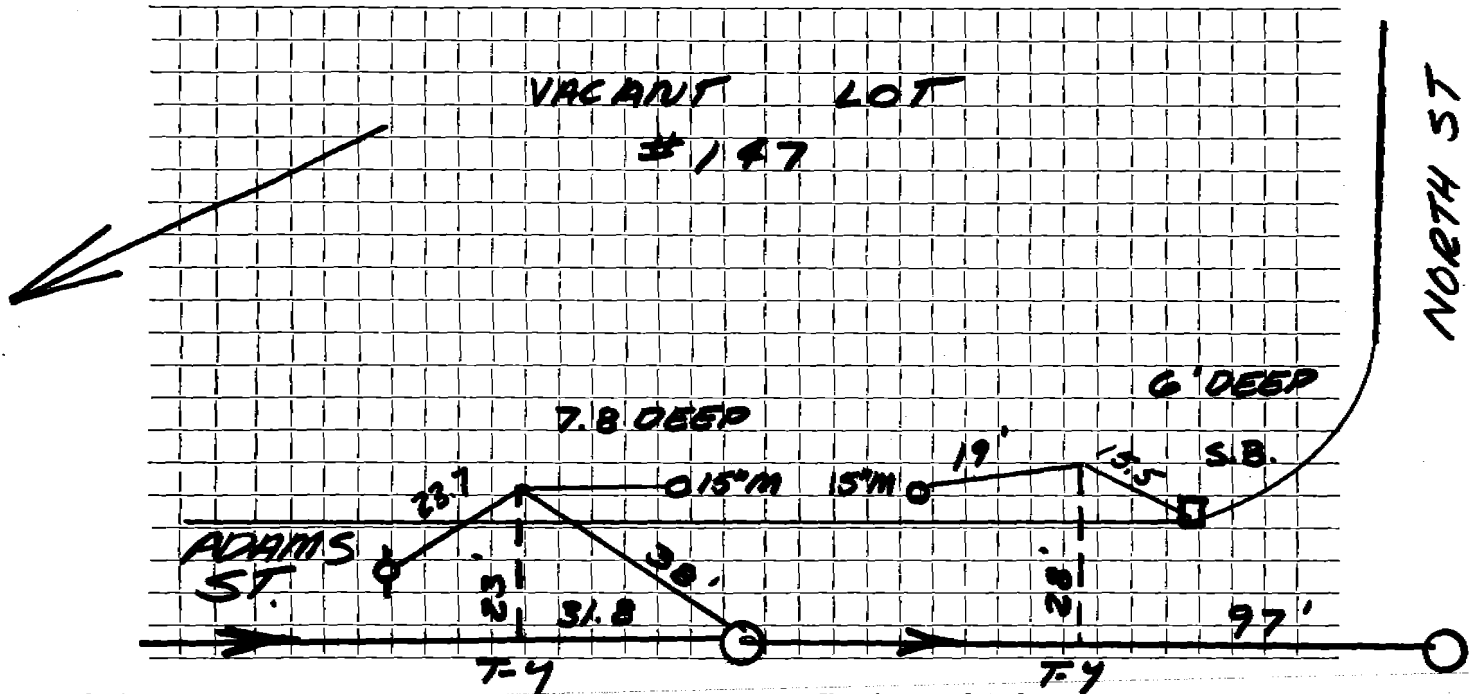

Connection made in Street. Work completed

Remarks:
.....
.....