

Name Barry St. George Jr.

Service No. 109

Address #150 ADAMS ST

Location

Kind of Pipe

Size

Size of Main

Repair—Renewal—New Service DeFelice #3137

Location NOV 19 1973

Date

Material

Amount

Total

Date

Amount

8/20/73 10'-~~PA~~ <sup>#</sup>ACB90 160.20

9-11-73

Deposit

160.28


9/15/73 52' 6" Transite pipe

DATE \_\_\_\_\_

TOWN OF LEXINGTON — BOARD OF PUBLIC WORKS

SEWER DIVISION

Sketch of Service Here

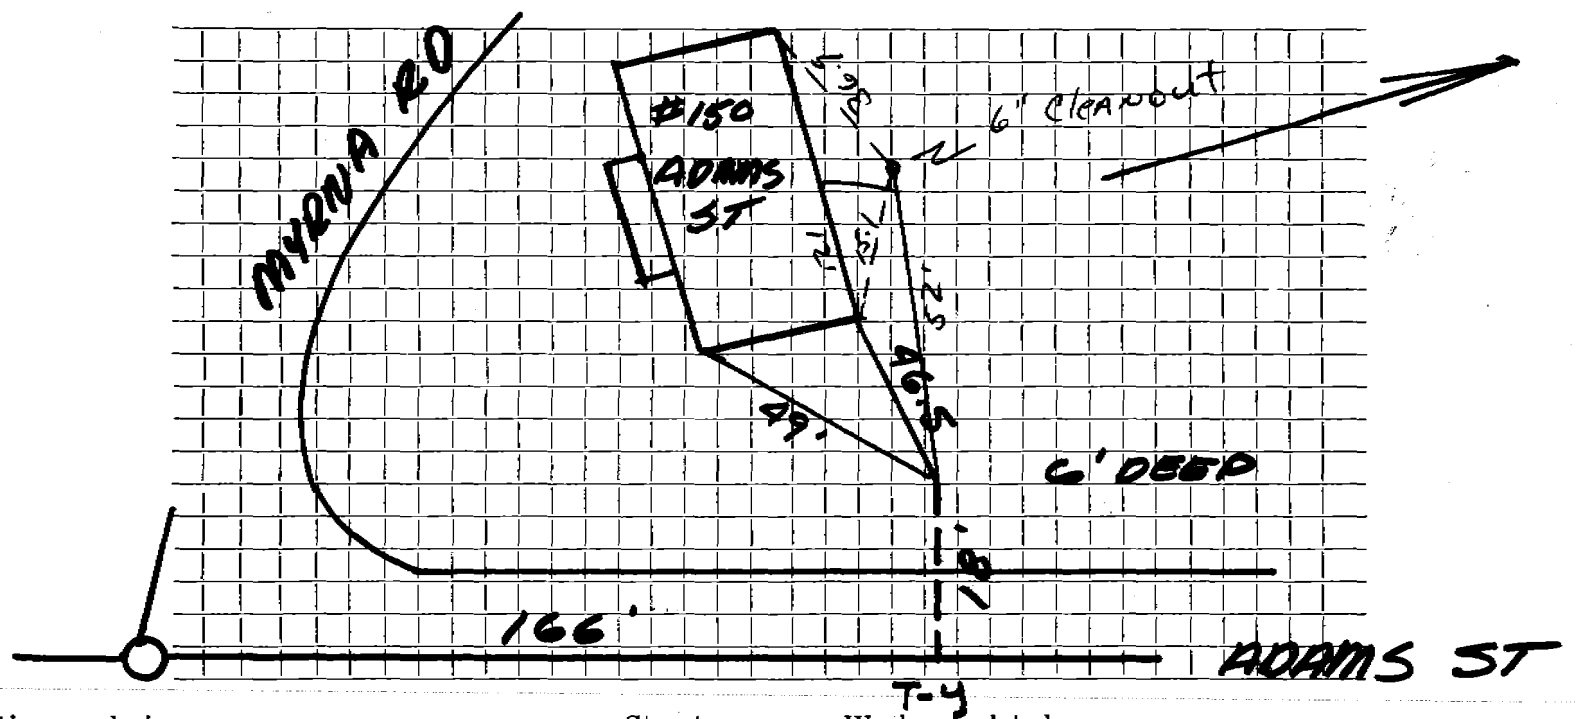

Connection made in ..... Street. Work completed .....

Remarks: .....  
.....  
.....