

Name *Warren Palmer*

Service No. *7 (1974)*

Address *154 ADAMS ST*

Location

Kind of Pipe *6" AC*

Size *6"*

Size of Main *6"*

Repair—Renewal—New Service *Trabino Const. # 2462*

Location *APR 8 1974*

Date	Material	Amount	Total	Date		Amount
------	----------	--------	-------	------	--	--------

<i>2/20/73</i>	<i>22.5' AC</i>	<i>200.25</i>		<i>3-25-74</i>	<i>Deposit</i>	<i>200.25</i>
----------------	-----------------	---------------	--	----------------	----------------	---------------


<i>3-27-74</i>	<i>27' 6" ACP</i>					
----------------	-------------------	--	--	--	--	--

	<i>10' 4" CI</i>					
--	------------------	--	--	--	--	--

DATE _____

TOWN OF LEXINGTON — BOARD OF PUBLIC WORKS
SEWER DIVISION

Sketch of Service Here

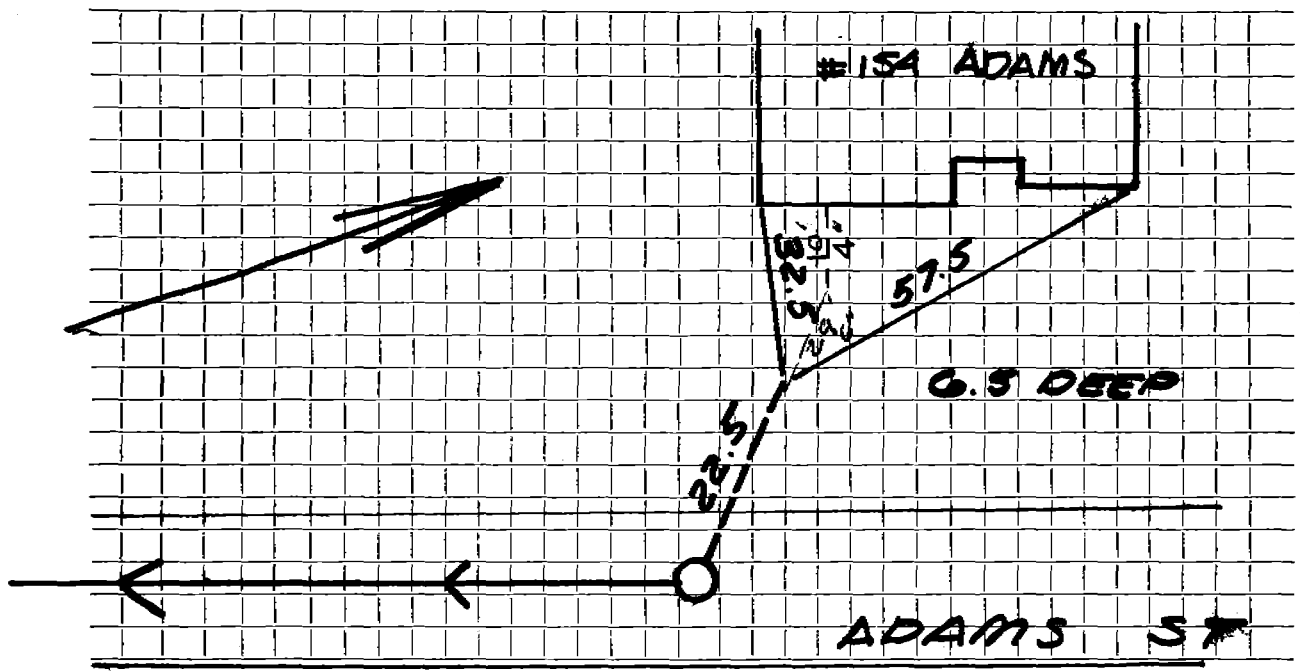

Connection made in Street. Work completed

Remarks:
.....
.....