

Name G. Arthur Simonds  
 Address 16 Adams Street,

Service No. ~~29~~ 5

Location same

Kind of Pipe Size Size of Main  
~~Repair - Renewal~~ New Service Location

Date 1937	Material	Amount	Total	Date	Amount
11/2/37	10 hrs. @ 50¢	5 00		October 29, 1937	100 00
<i>Com 12-14-37</i>	41 " @ 55¢	22 55		<i>Deposited</i>	<i>90 69</i>
	28½ " @ 60¢	17 10		<i>Refunded</i>	
	10 " @ 70¢	7 00	51 65		
	10% overhead		5 17		
	52' 6" Pipe		13 00		
	10' 4" Iron Pipe		5 00		
	1 1/8 6" Bend		1 00		
	Jointing compound		3 12		
	3 hrs. trucking @ 75¢		2 25		
	Trench Repairs		9 50		
	Labor		90 69		

Hadley Press, Inc., Lexington

TOWN OF LEXINGTON—BOARD OF PUBLIC WORKS  
SEWER DIVISION

DATE 7/1/19

NO. \_\_\_\_\_


The undersigned applies for the construction of a particular sewer connecting No. 1710 Street and hereby agrees to comply with the Rules and Regulations governing the construction and use of Particular Sewers, as now or at any future time established by the Board of Selectmen.

Am't. of Estimate \$ 100.00

Am't. Paid \$ \_\_\_\_\_

Owner \_\_\_\_\_

Sketch of Service Here

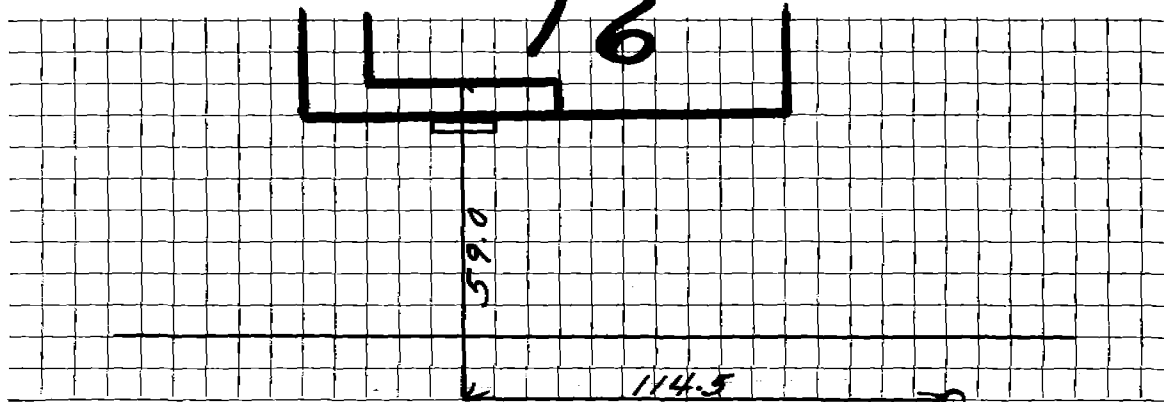

Connection made in \_\_\_\_\_ Street.

Work completed \_\_\_\_\_ 19

Remarks: