

Name Felicia Collins

Service No.

Address 17 Adams Street

Location

Kind of Pipe

Size

Size of Main

Repair—Renewal—New Service

Suburbanite #2477

Location

Date

Material

Amount

Total

Date

Amount

Pipe in Easement No Charge

4/19/74

89'

6" Transite pipe


10'

4" Cast Iron pipe

DATE \_\_\_\_\_

TOWN OF LEXINGTON — BOARD OF PUBLIC WORKS  
SEWER DIVISION

Sketch of Service Here

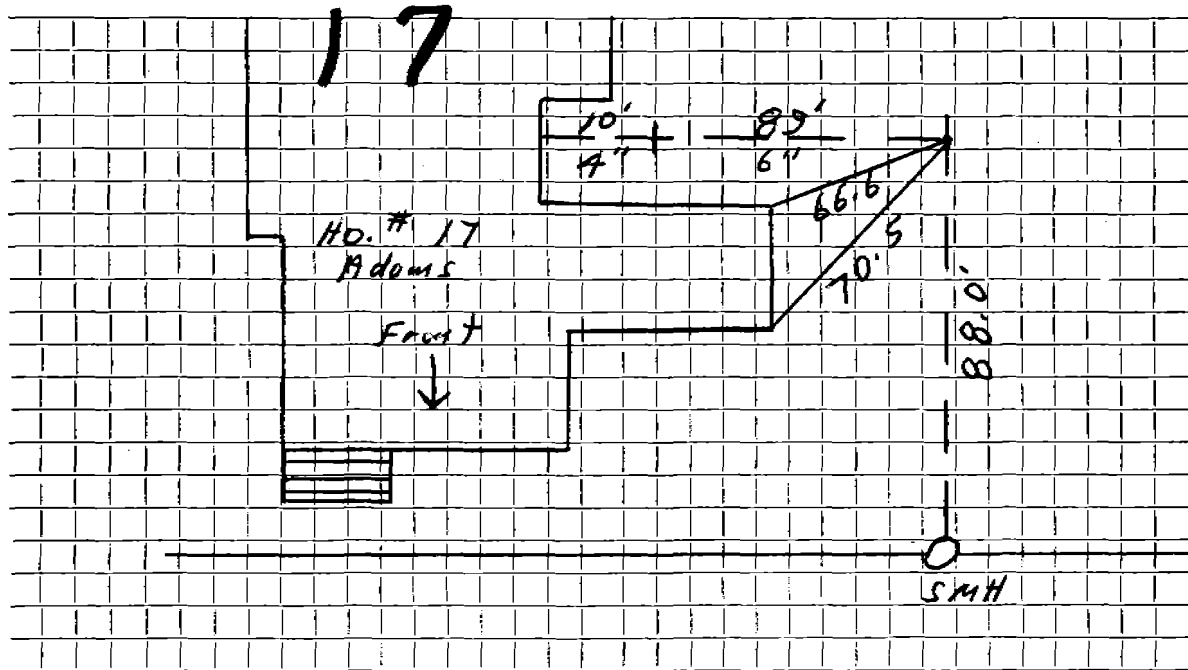

Connection made in Juniper Street.      Work completed .....

Remarks: .....  
.....  
.....