




DATE APRIL 25 1997

TOWN OF LEXINGTON — BOARD OF PUBLIC WORKS  
SEWER DIVISION

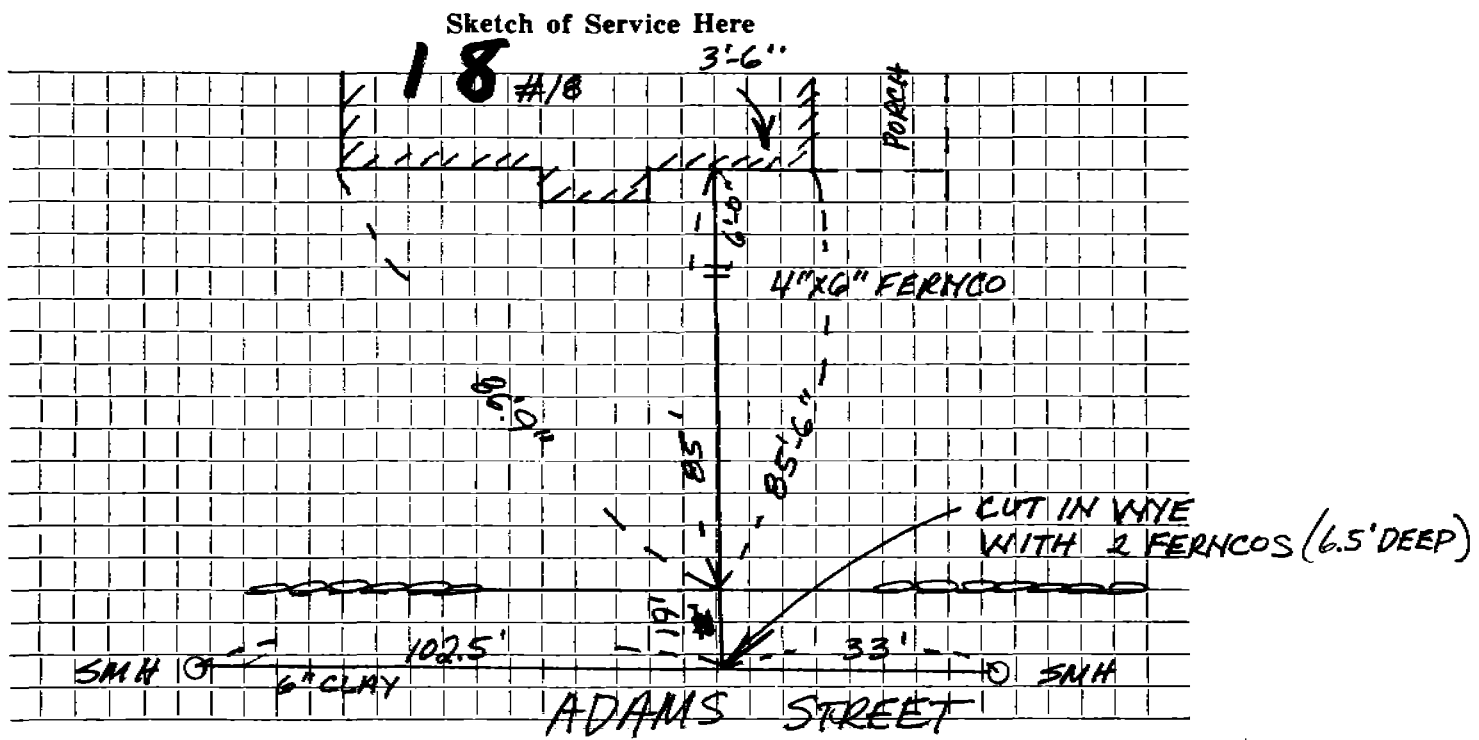

Connection made in ADAMS STREET..... Street. Work completed J.M. MCLAUGHLIN.....

Remarks: .....