


DATE 11-12-82

TOWN OF LEXINGTON — BOARD OF PUBLIC WORKS
SEWER DIVISION

20

Sketch of Service Here

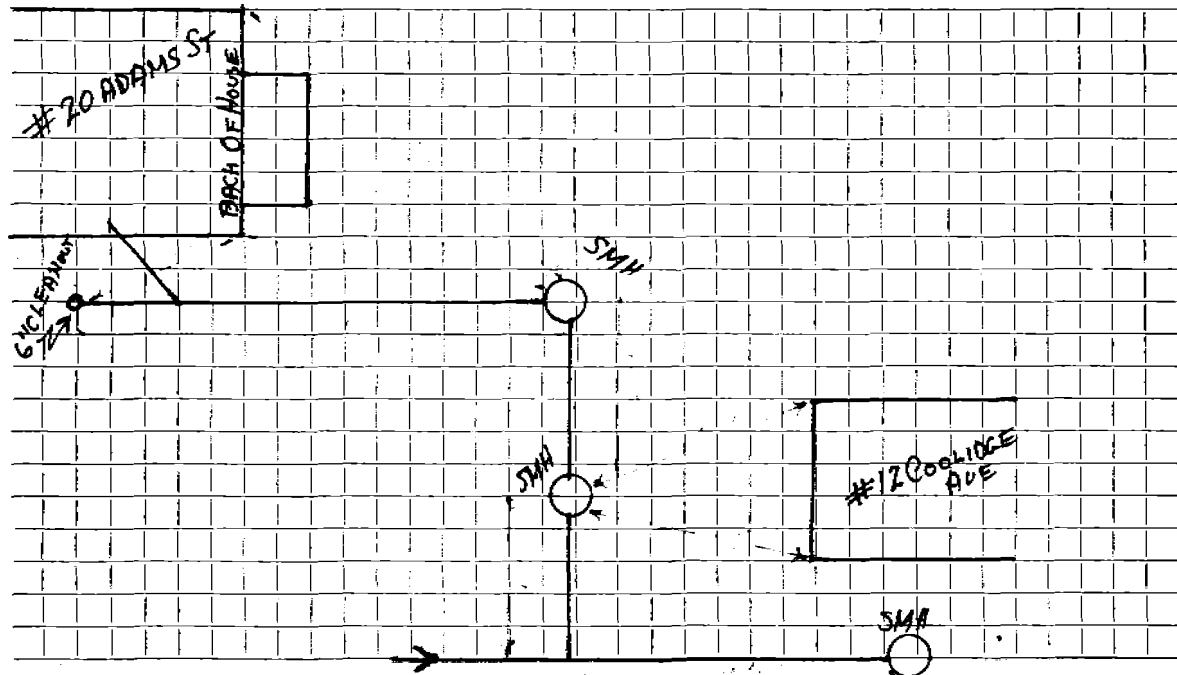

Connection made in COOLIDGE AVE Street. Work completed 11-12-82

Remarks:
.....
.....