

Name John H. Brooks

Service No. 174

Address 29 Adams Street

Lexington

Location

Kind of Pipe

Size

Size of Main

Repair/ Renewal - New Service

COM. 2-4-52

Location

Date	Material	Amount	Total	Date	Amount
1/2/52	Labor	55 90	55 90	10-25-51	Deposited 175 00
	10% overhead		5 59	2-4-52	9 <sup>th</sup> -funded (31 72
	48' - 6" sewer pipe @ .342		16 41		
	joint compound		2 88		143 28
	7 hrs. Littlefield shovel @ \$7.		49 00		
	2 hrs. trucking @ .75		1 50		
	patching 12 x 3		12 00		
			143 28		
				1.24.01	Respond + Measure
	Labor				Plumber hit Block at 90' from Cams out at Back of house

TOWN OF LEXINGTON—DEPT. OF PUBLIC WORKS  
SEWER DIVISION

DATE .....


NO. ....

The undersigned applies for the construction of a particular sewer connecting No. ....  
Street and hereby agrees to comply with the Rules and Regulations governing the construction and use of Particular  
Sewers, as now or at any future time established by the Board of Selectmen.

Am't of estimate \$.....

Am't Paid \$.....

..... Owner

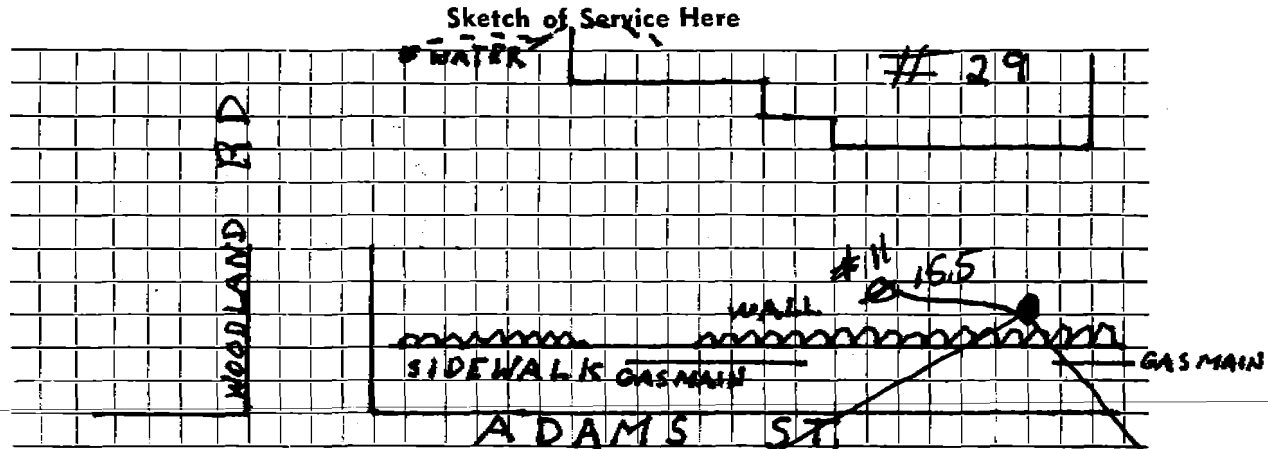

Connection made in ..... Street. Work completed ..... 19..

Remarks: Service broken by Gas Co. in sidewalk