

Name Eveleyn Beauchesne

Service No. 211

Address 32 Adams Street

Location

Kind of Pipe

Size

Size of Main

~~Repair - Renewal~~ New Service W.O. #8361

Location **JUN 29 1964**


Date	Material	Amount	Total	Date	Amount
3/20/61	Labor	80.26		12-4-63	300 00
	"	<u>54.46</u>	134 72	6-29-64	4 15
			13 47		295 85
	98' 6" Transite Pipe @ .82		80 36		
	1 90° Transite Elbow		4 09		
	1 11¼° Transite Bend		4 09		
	1 Duplex Adapter		1 62		
	5 Hrs. Town Shovel @ 6.50		32 50		
	4 Hrs. Trucking @ 3.00		12 00		
	13 X 3 Patch		<u>13 00</u>		
			295 85		

Deposit
Retuned

DATE _____

TOWN OF LEXINGTON — BOARD OF PUBLIC WORKS
SEWER DIVISION

Sketch of Service Here

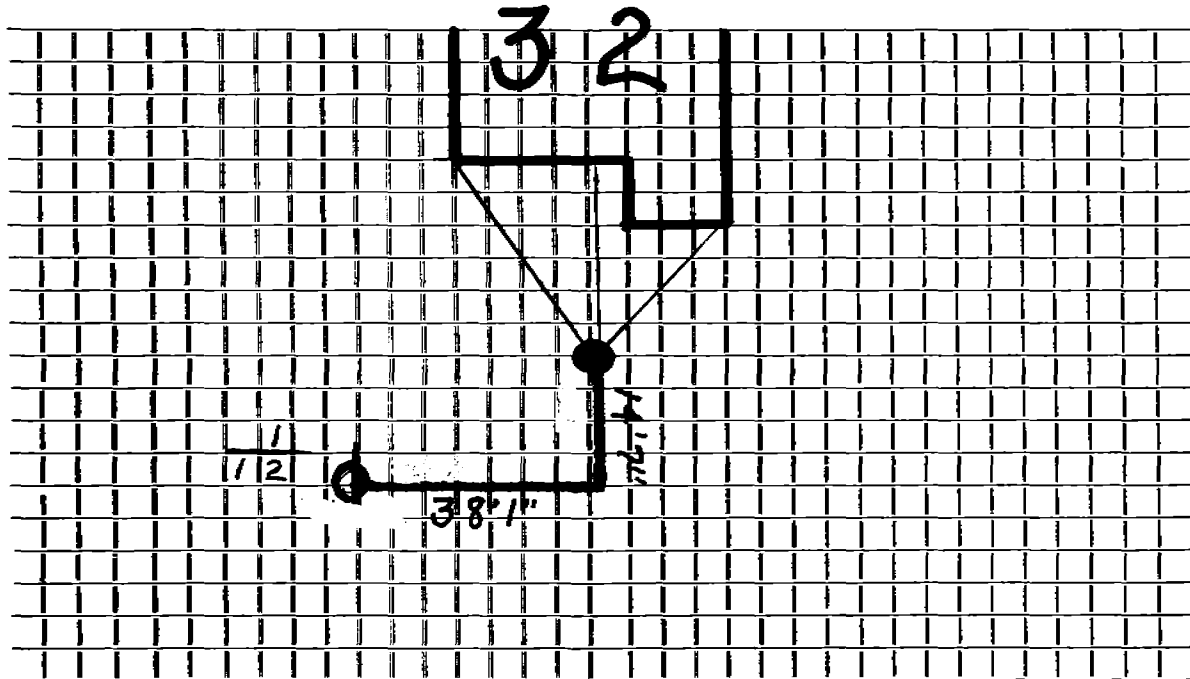

Connection made in Street. Work completed

Remarks:

.....

.....