

Name George Graves

Service No. 67

Address 33 Adams Street

Location

Kind of Pipe

Size

Size of Main

~~Repair - Overhead~~ New Service

W.O. #8021

Location Comm 10-28-63


Date		Material	Amount	Total	Date	Amount
6/17/63	Labor		95 02		6-12-63	350 00
6/18/63	"		102 25		4-17-64	41 41
6/19/63	"		31 23			391 41
			228 50			
	10% Overhead		22 85	251 35		
	70' - 6" Transite Pipe @ .82			57 40		
	1 - 11 $\frac{1}{4}$ " Transite Bend			4 09		
	1 - 22 $\frac{1}{2}$ " Transite Bend			4 09		
	1 - 6" Adapter			1 62		
	3 3/4 tons Crush Run @ 1.85			6 94		
	12x3 Patch			12 00		
	6 hrs. Town Shovel @ 6.50			39 00		
	5 hrs. Trucking @ 3.00			15 00		
				391 41		
						41.41

DATE _____

TOWN OF LEXINGTON — BOARD OF PUBLIC WORKS

SEWER DIVISION

Sketch of Service Here

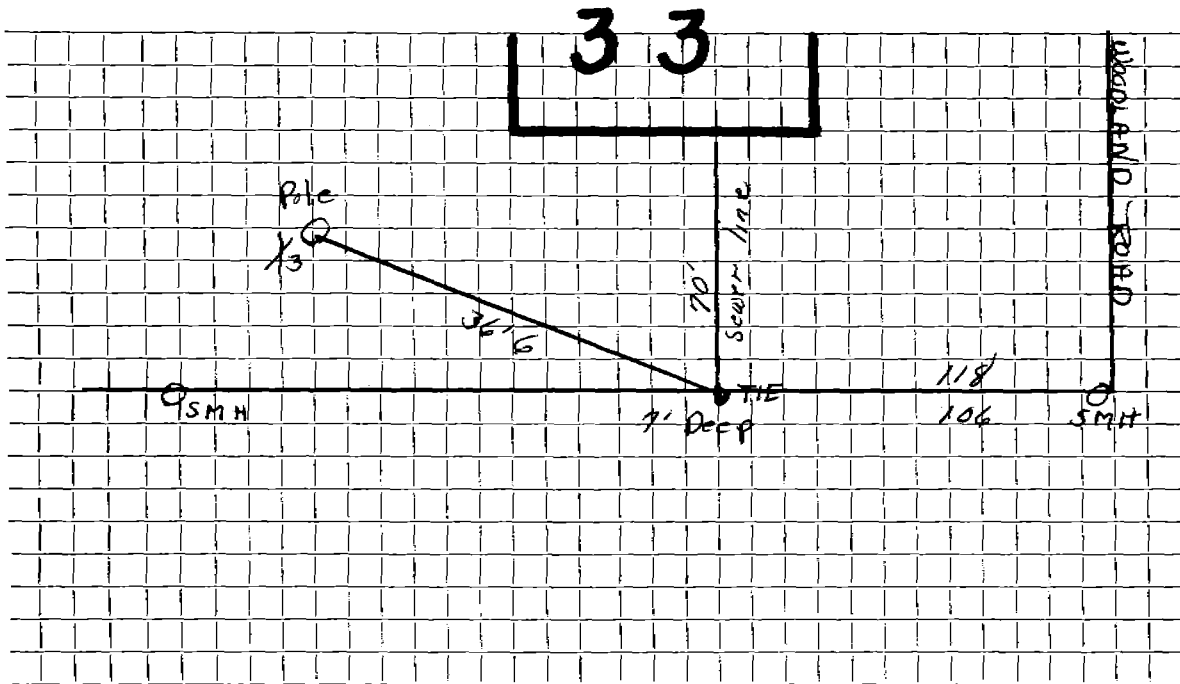

Connection made in Street. Work completed

Remarks:

.....

.....