

Name *George Redick*

Service No.

Address *#38 ADAMS ST*

Location

Kind of Pipe *PVC*

Size *6"*

Size of Main *8" PVC*

~~Repair~~ ~~Renewal~~ ~~New Service~~ *Cataldo #3941*

Location


Date	Material	Amount	Total	Date	Amount
<i>12/7/84</i>	<i>200' 6" PVC Pipe</i>				
	<i>10' 4" CIP</i>				
	<i>1 6" x 4" Fernco Adaptor</i>				
	<i>2 5" Precast Manholes</i>				
	<i>2 S.M.H. Frames & Covers</i>				
				<i>12/7/84</i>	<i>25' 6" PVC Pipe</i>
					<i>1 6" x 90° Elbow</i>
					<i>1 6" x 8" Saddle</i>

OUTSIDE

DATE Dec 1984

TOWN OF LEXINGTON — BOARD OF PUBLIC WORKS
SEWER DIVISION

Sketch of Service Here

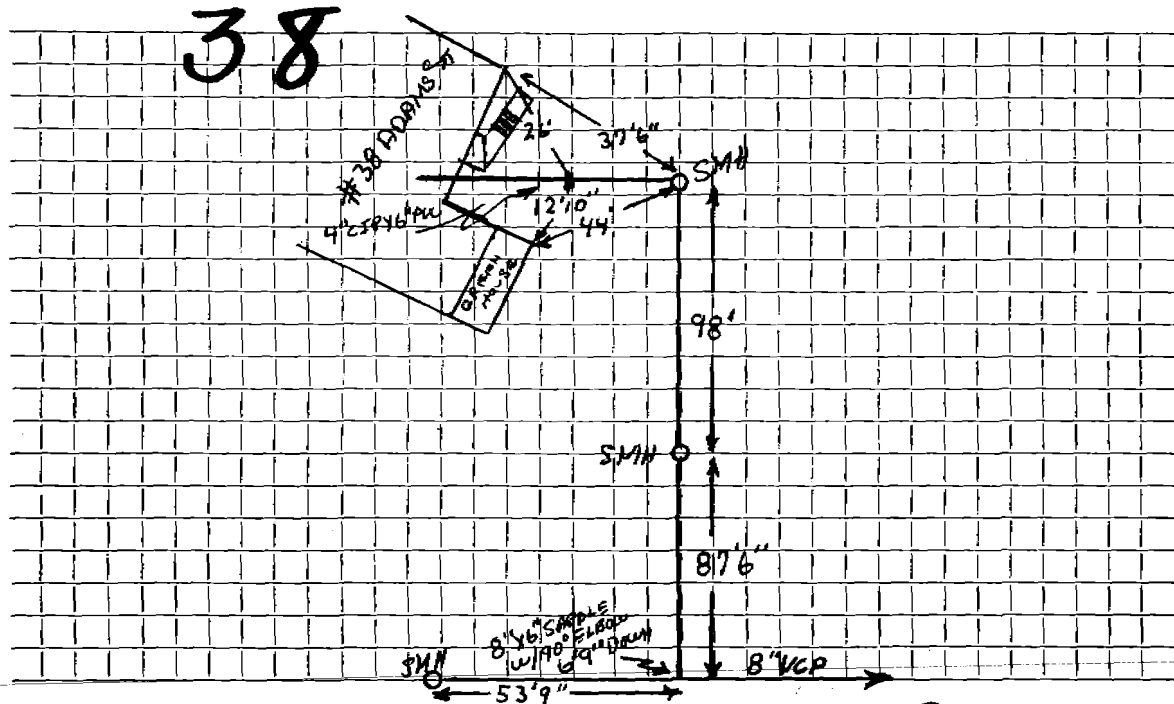

Connection made in ADAMS ST. Street. Work completed DEC. 12, 1984

Remarks:

.....

.....