




DATE \_\_\_\_\_

TOWN OF LEXINGTON — BOARD OF PUBLIC WORKS  
SEWER DIVISION

Sketch of Service Here

LOG

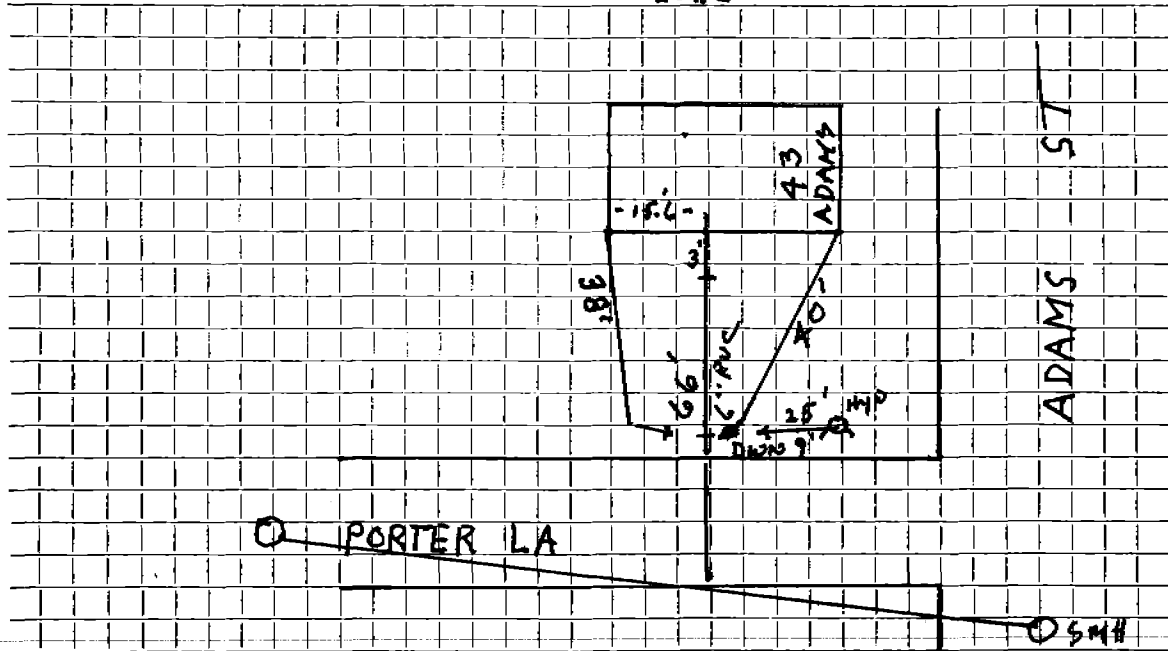

Connection made in PORTER LA ..... Street.      Work completed .....

Remarks: .....

.....

.....