


DATE _____

TOWN OF LEXINGTON — BOARD OF PUBLIC WORKS
SEWER DIVISION

Sketch of Service Here

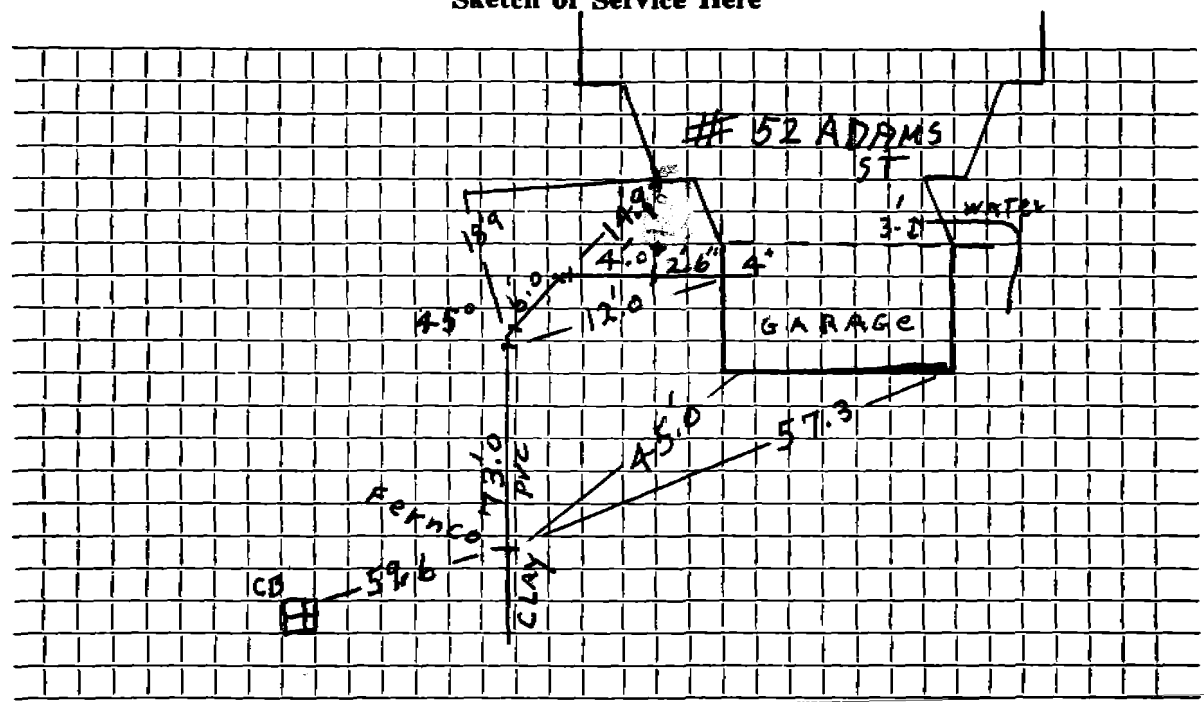

Connection made in

Street.

Work completed 4/7/66 J. McLaughlin.....

Remarks:
.....
.....