

Name Carlton W. Batson

Service No. 69

Address 56 Adams Street

Location

Comm. 9/30/57

Kind of Pipe

Size

Size of Main

Repair--Renewal--New Service

Location

Date	Material	Amount	Total		Date	<i>Deposit</i> <i>Refund</i>	Amount	
6/4/57	Labor	74 28			<i>5-21-57</i>		# 200 00	
	10% overhead	7 43	81	71	<i>9-30-57</i>	<u>27 64</u>		
	85' - 6" Transite Pipe @ .7020		52.	65		# <u>172 36</u>		
	3 hrs. Town Shovel @ 6.50		19	50				
	2 hrs. Trucking @ .75		1	50				
	Patching 17x3		17	00				
			172	36				
	Labor							

TOWN OF LEXINGTON—DEPT. OF PUBLIC WORKS
SEWER DIVISION

DATE.....

NO.


The undersigned applies for the construction of a particular sewer connecting No.....
Street and hereby agrees to comply with the Rules and Regulations governing the construction and use of Particular
Sewers, as now or at any future time established by the Board of Selectmen.

Am't of estimate \$.

Am't Paid \$.

..... Owner

Sketch of Service Here

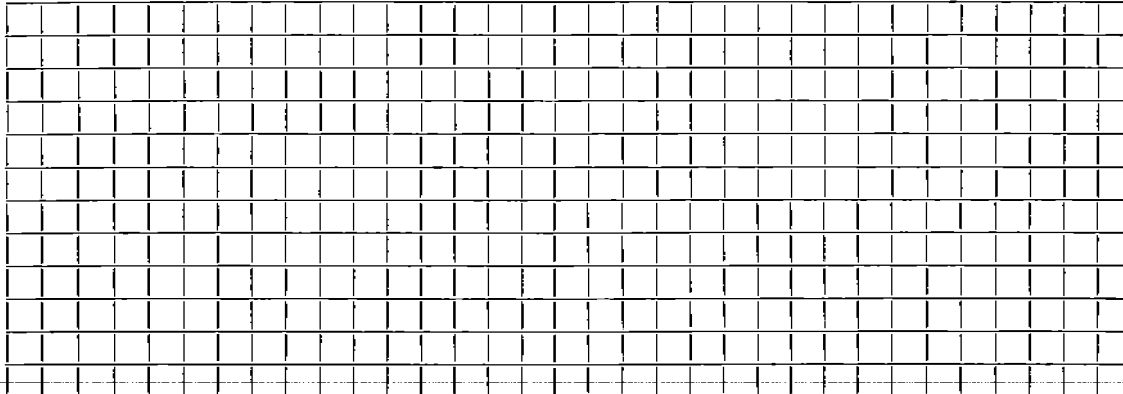

Connection made in..... Street.

Work completed.....19..

Remarks: