


DATE 7/26/95

TOWN OF LEXINGTON — BOARD OF PUBLIC WORKS

DRAIN ~~SEWER~~ DIVISION

1

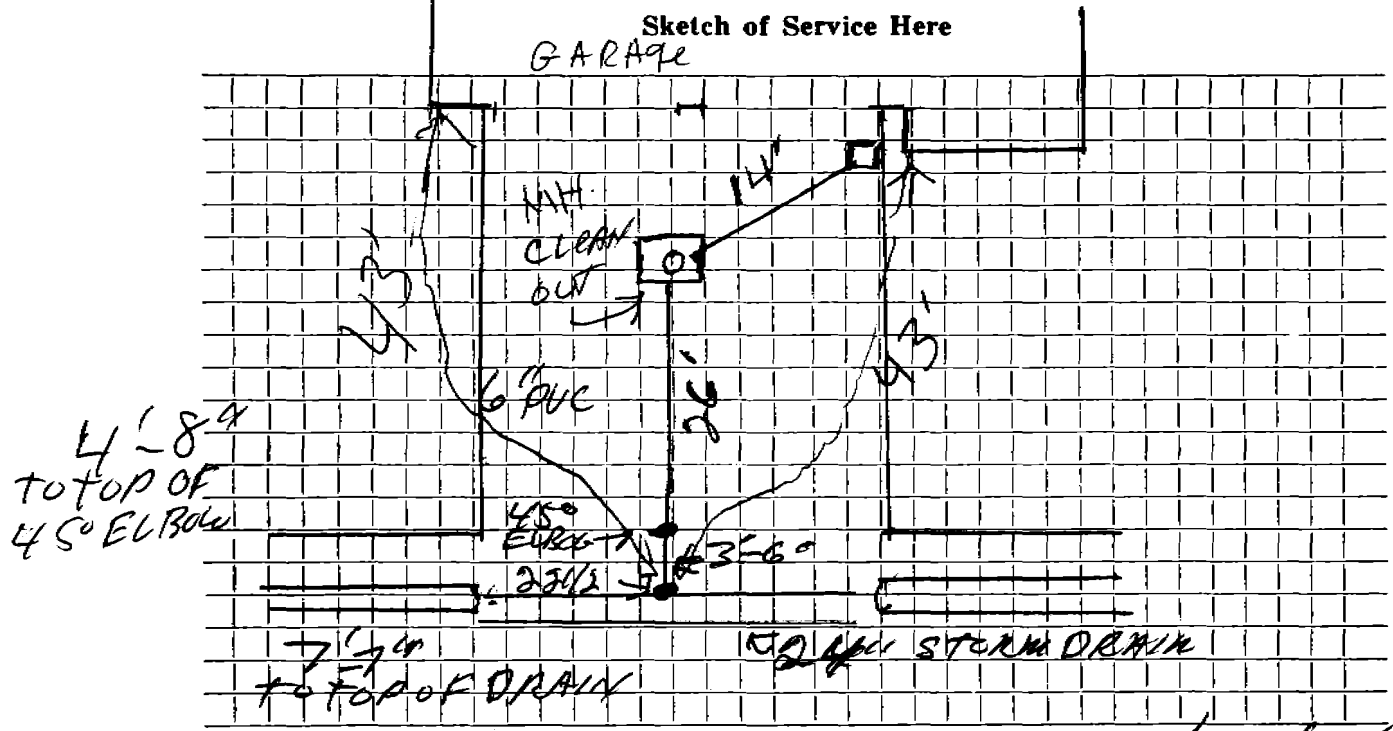

Connection made in HATHAWAY RD Street. Work completed 7/26/95

Remarks:

.....

.....