

Name ~~Walter Rutledge~~ **ANTONIA FORNI**Service No. 123

Address 64 Adams Street

## Location

Kind of Pipe

Size

Size of Main

~~Repair/Renewal~~—New Service

COM. 12-31-54

PERMIT NO. 0980  
KIRKLAND & SHAW

Location

Date	Material	Amount	Total	Date	Amount
12/27/54	Labor	47 37		12-27-54	206.00
12/28/54	"	47 37	94 74	12-31-54	(43 21)
	10% overhead		9 47		162 79
	66' 6" Sewer pipe @ .32		21 12		
	Joint compound		3 96		
	4 hrs. Town shovel @ 5.00		20 00		
	2 hrs. trucking @ .75		1 50		
	Patching 12x3		12 00		
			162 79	FEB. 97	HAD SAUCE Red out by Plumber Problem by Tree on property
JULY 2, 1997	30.4' - 6" $\phi$ PVC 1 - 4" X 6" FERNCO <del>1 - 6" X 6" FERNCO</del>			<u>6-23-97</u>	REPAIR MADE from back of sidewalk to edge of ROAD

TOWN OF LEXINGTON—DEPT. OF PUBLIC WORKS

SEWER DIVISION

DATE .....


NO. ....

The undersigned applies for the construction of a particular sewer connecting No. .... Street and hereby agrees to comply with the Rules and Regulations governing the construction and use of Particular Sewers, as now or at any future time established by the Board of Selectmen.

Am't of estimate \$.....

Am't Paid \$.....

..... Owner

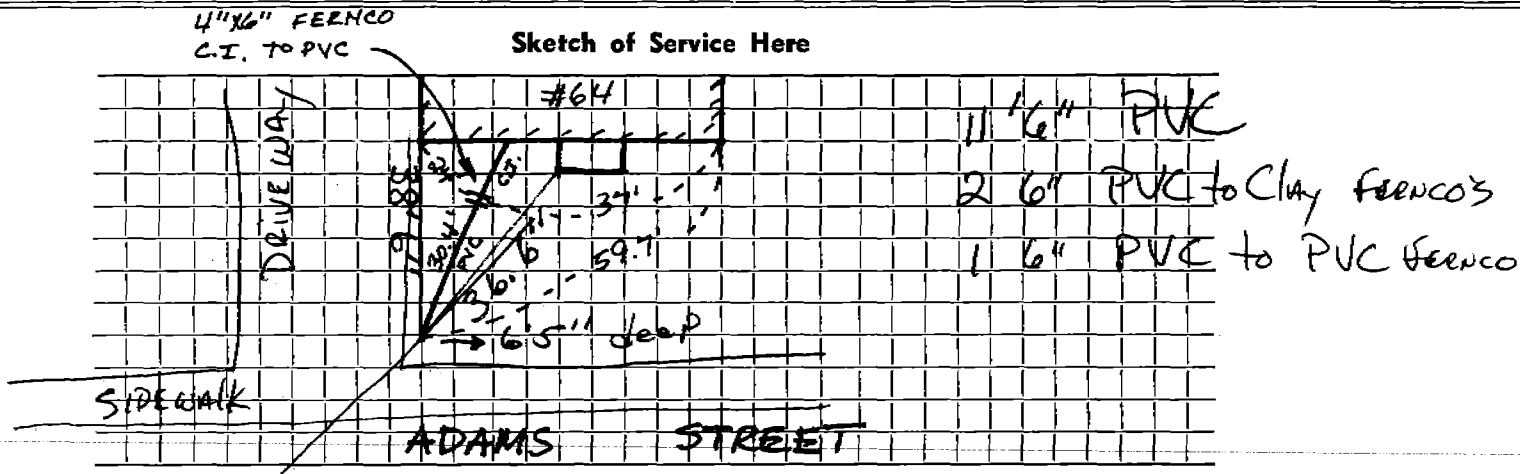

Connection made in ..... Street.

Work completed ..... 19..

Remarks:

BOOK 97-3

J.W.