

Name Victor A. Scenna

Service No. 165

Address 68 Adams Street

Location

Kind of Pipe

Size

Size of Main

~~Repair~~ Renewal - New Service

COM. 10-31-55

Location

Date	Material	Amount	Total	Date	Amount
8-24-55	Labor	49 35		8-12-55	Deposited 200 00
	10% overhead	4 94	54 29	11-1-55	Refunded (65 25)
	66' - 6" sewer pipe @ .32		21 12	4-3-78	Renewal 134 75
	1 - 6" elbow		1 88		30' 6" Transite
	joint compound		3 96		2 5' X 6" Transite Nipple
	2 hrs. trucking @ .75		1 50		1 6" Transite Adapter
	5 1/3 hrs. Littlefield shovel @ 7.50		40 00		
	12 x 3 patching		12 00		
			134 75		
				2/1/78	Solids at 75' out from house
				3-15-78	Solids or sand. 50' out from house
	Labor			4-1-78	Solids 65-70 ft. out

TOWN OF LEXINGTON—DEPT. OF PUBLIC WORKS

SEWER DIVISION

DATE

NO.


The undersigned applies for the construction of a particular sewer connecting No. Street and hereby agrees to comply with the Rules and Regulations governing the construction and use of Particular Sewers, as now or at any future time established by the Board of Selectmen.

Am't of estimate \$.....

Am't Paid \$.....

..... Owner

Sketch of Service Here

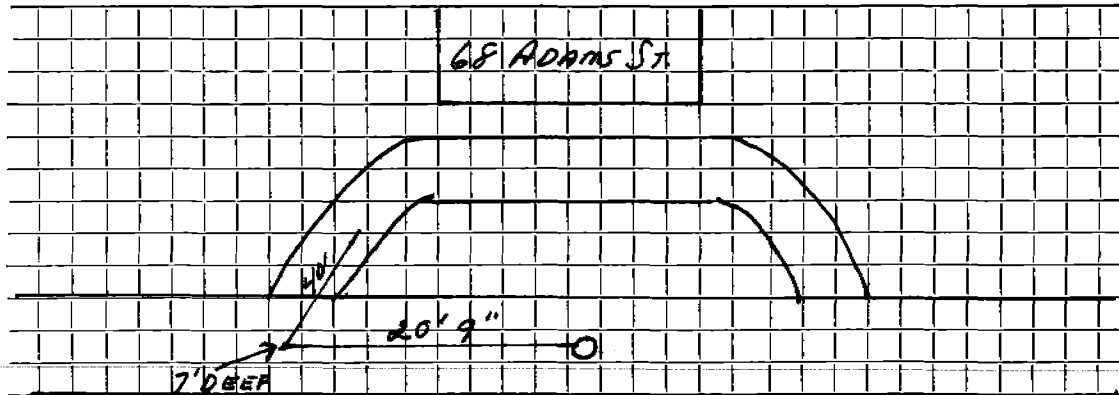

Connection made in Street.

Work completed 19..

Remarks: