


DATE _____

TOWN OF LEXINGTON — BOARD OF PUBLIC WORKS
SEWER DIVISION

Sketch of Service Here

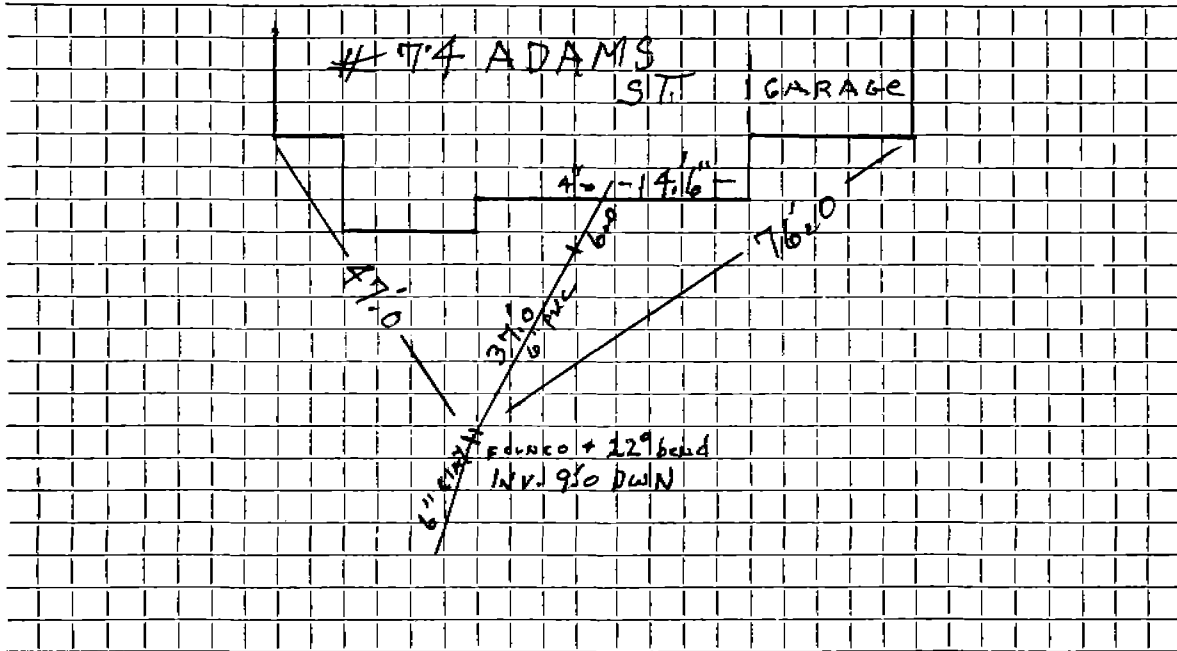

Connection made in Street.

Work completed .. 9/13/05 .. J. McIsugklin ..

Remarks: ..
.....
.....