

Name William Ryan

Service No. 62

Address 8 Adams Street.

Location

Kind of Pipe

Size

Size of Main

Repair—Renewal—New Service

Location

Conn 2-5-60


Date	Material	Amount	Total	Date	Amount
5-16-60	Labor 67.05			4-29-60	400 00
5-17-60	" 65.95	133 00		7-5-60	79 32
	10% O.H.	13 30	146 30		320 68
	140' 6" Transite Pipe @.70		98 00		
	1 6" Clay Elbow		1 88		
	11 Hrs. Pippin Shovel @4.50		49 50		
	4 Hrs. Trucking @ 3.00		12 00		
	13x3 Patch		13 00		
			320 68		

DATE _____

TOWN OF LEXINGTON — BOARD OF PUBLIC WORKS

SEWER DIVISION

Sketch of Service Here

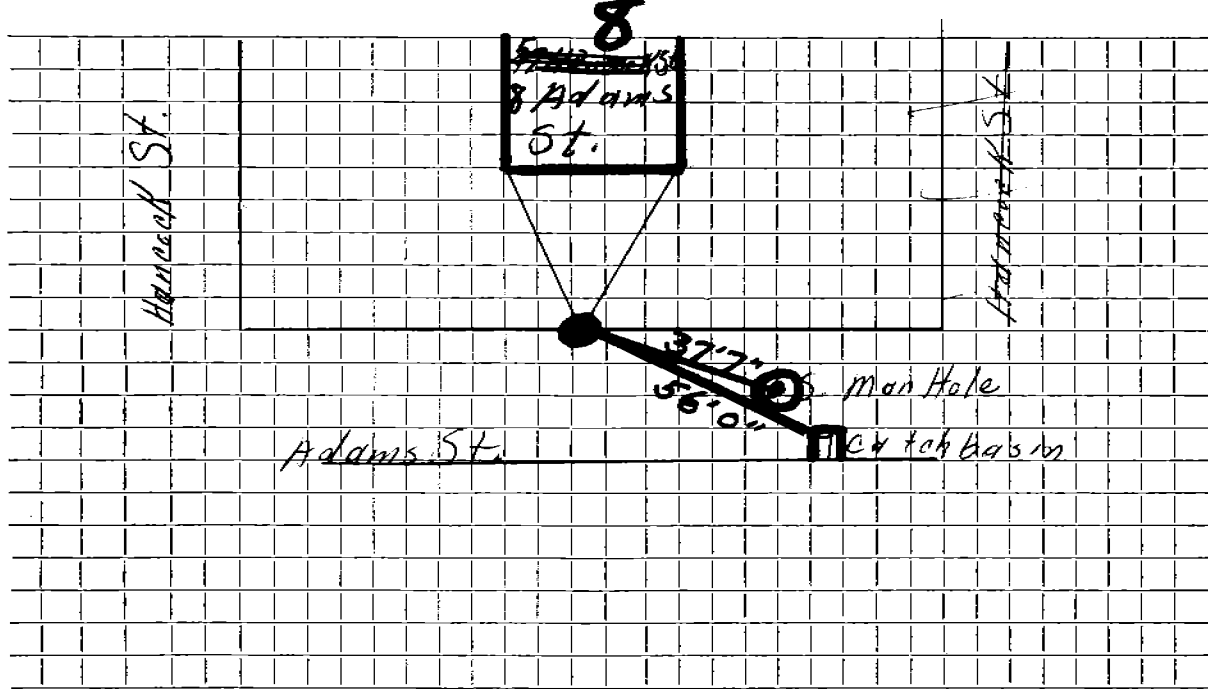

Connection made in Street. Work completed

Remarks:
.....
.....