

Name Custom Colonials, Inc.

Service No. 64

Address 80 Adams Street

Location

Comm. 9/30/57

Kind of Pipe

Size

Size of Main

~~Repair~~ ~~Renewal~~ ~~New Service~~

Location

Date	Material	Amount	Total	Date	Amount
5/24/57	Labor	22 84		5-16-57	Deposit \$150 00
5/25/57	"	48 42		10-18-57	Paid by renewal
		71 26			mir. N.C. # 92 9 05
	10% overhead	7 13	78 39		NON CHARGE \$159 05
	55' - 6" Transite Pipe @ .7020		38 61	5/18/57	Labor 39 54
	1 - 6" Bend (Transite)		5 80		
	3 hrs. Town Shovel @ 6.50		19 50		
	1 hr. Rodgers Trailer		3 00		
	1 hr. Trucking=		75		
	1 hr. Trucking		3 00		
	10x3 Patch		10 00		
			159 05		
	Labor				

TOWN OF LEXINGTON—DEPT. OF PUBLIC WORKS
SEWER DIVISION

DATE.....

NO.


The undersigned applies for the construction of a particular sewer connecting No.....
Street and hereby agrees to comply with the Rules and Regulations governing the construction and use of Particular
Sewers, as now or at any future time established by the Board of Selectmen.

Am't of estimate \$.

Am't Paid \$.

..... Owner

Sketch of Service Here

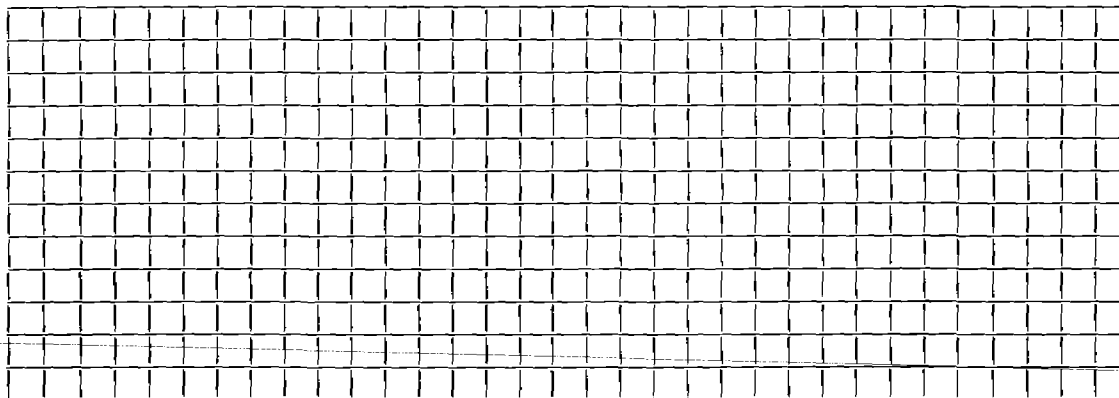

Connection made in..... Street.

Work completed.....19..

Remarks: