




DATE 8/20/92

TOWN OF LEXINGTON — BOARD OF PUBLIC WORKS

SEWER DIVISION

ADAMS ST.

Sketch of Service Here

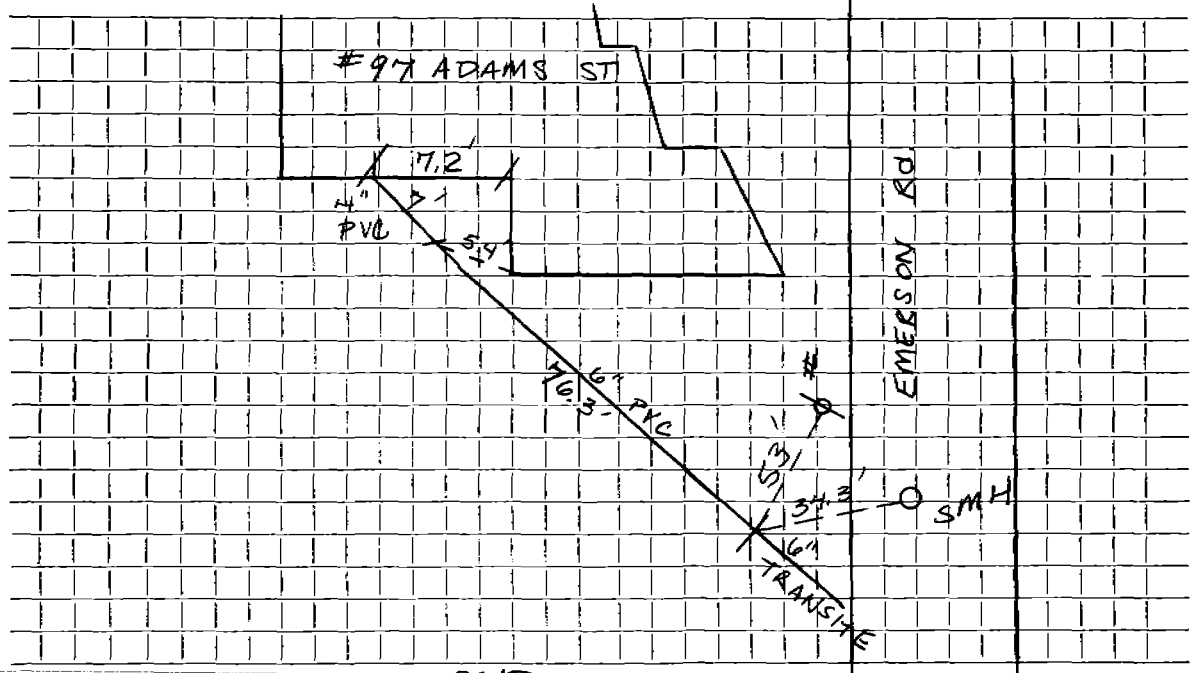

Connection made in EMERSON ROAD Street. Work completed .....

Remarks: CONTR: J. McLAUGHLIN .....

INSP: P. BARROWS .....

CONNECTION MADE IN EMERSON Rd .....