

Name John Callahan

Service No.

Address 98 ADAMS ST.

Location

Kind of Pipe CI & PVC

Size 4" & 6"

Size of Main 8"

Repair—Renewal—New Service McKee #0226

Location


Date		Material	Amount	Total	Date		Amount
2-5-	93	44 LF 6" PVC			2-1-	93	176.00
		22 LF 4" CI					
		6" x 6" FERRO					
		4" x 6" FERRO					
		6" x 6" WYE C.O.					
		2' - 6" NIPPLE w/CAP					
		3 - 6" 22° ELBOWS					
Dec 1969	22'	6" Transite pipe @ \$8.00		\$176.00			



DATE \_\_\_\_\_

TOWN OF LEXINGTON — BOARD OF PUBLIC WORKS  
SEWER DIVISION

Sketch of Service Here **98**

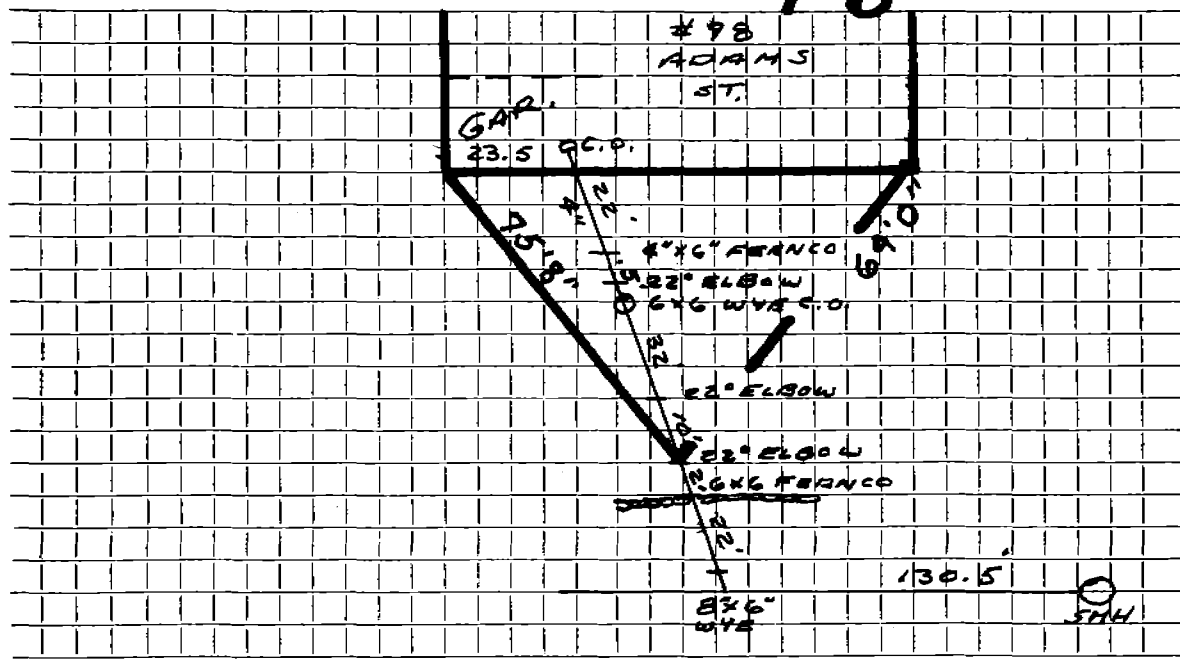

Connection made in ADAMS Street. Work completed .....

Remarks: T' DOWN FROM TOP OF STONEWALL @ B.T. SDWK.

.....  
.....