

Name

Curt: Berger

Service No.

Address

36 Adams St

Location

Kind of Pipe

SDR 35 PVC

Size

6"

Size of Main

Repair—Renewal—New Service

Renewal

Location

Date

Material

Amount

Total

Date

Amount

8/12/19

22° bend (down)

tee w/

6" cleanout


6" SDR PVC

Fern Co 6"

DATE 8/12/19

TOWN OF LEXINGTON — BOARD OF PUBLIC WORKS  
SEWER DIVISION

Sketch of Service Here

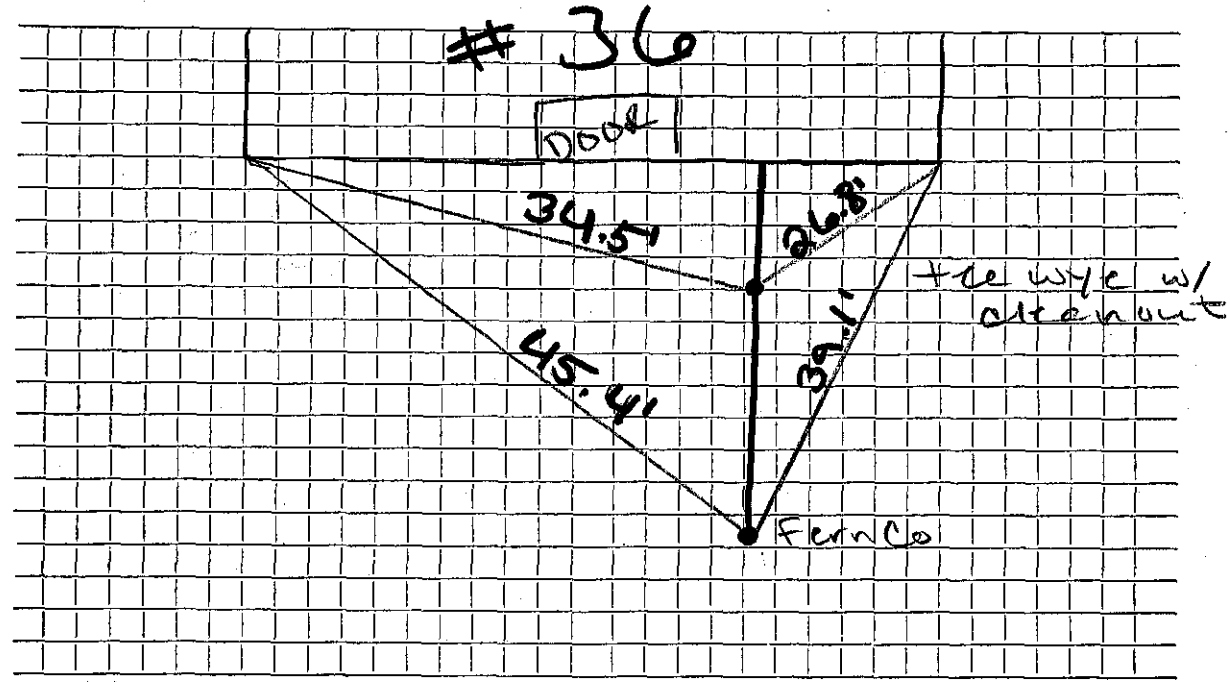

Connection made in ... Adams ... Street. Work completed .....

Remarks: .....  
.....  
.....