

Name

Service No.

Address

75 Adams St

Location

Kind of Pipe

SDR 35

Size

6"

Size of Main

Repair—Renewal—New Service

Location

Date

Material

Amount

Total

Date

Amount

10x16 FernCo

6" PVC


cleanout

cover = 4'

DATE \_\_\_\_\_

TOWN OF LEXINGTON — BOARD OF PUBLIC WORKS  
SEWER DIVISION

Sketch of Service Here

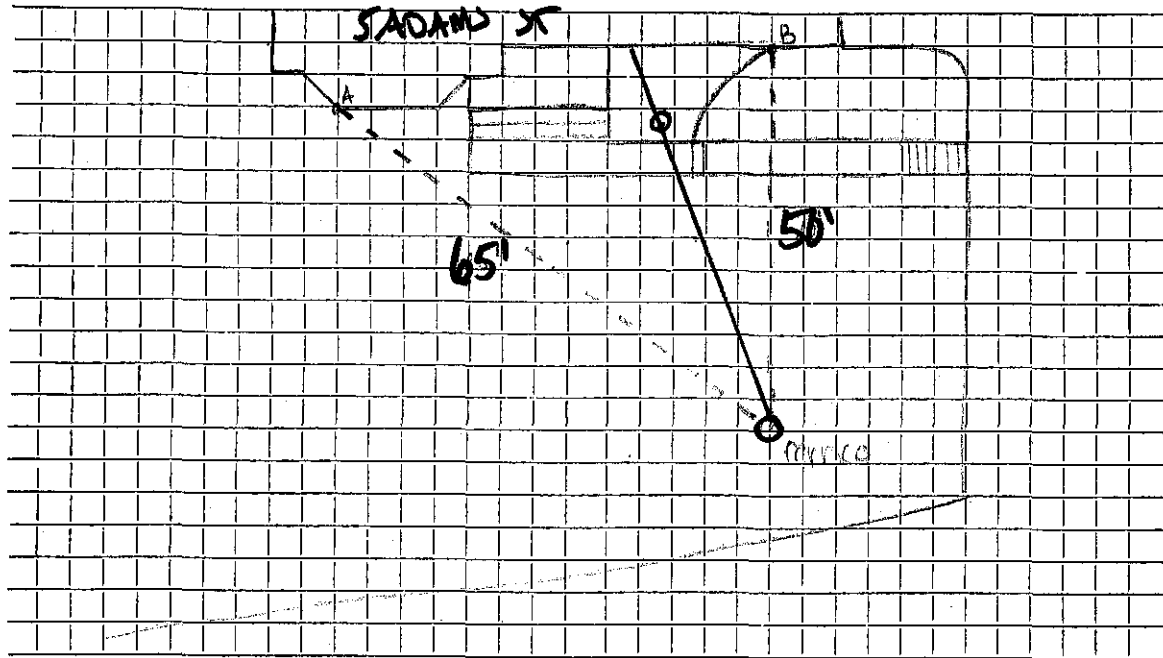

Connection made in ..... Street. Work completed .....

Remarks: .....  
.....  
.....