

Name Waverley Construction Co.

Service No. 31 1045

Address 12 Aerial Street

Lexington, Mass.

Location 12 Aerial Street

Kind of Pipe

Size

Size of Main

~~Repair~~ ~~Renewal~~ New Service

Location

Date	Material	Amount	Total	Date	Amount
Oct. 28, '46	Labor	35 53	35 53	Oct 22 46	60 00
	10% Overhead		3 55	Dec 2 46	7 07
	42' - 6" Sewer Pipe @ .234		9 83		52 93
	Joint Compound		2 52		
	Trucking 2 hrs. @ .75		1 50		
			52 93		
	Labor				

TOWN OF LEXINGTON—DEPT. OF PUBLIC WORKS

SEWER DIVISION

DATE


NO.

The undersigned applies for the construction of a particular sewer connecting No. Street and hereby agrees to comply with the Rules and Regulations governing the construction and use of Particular Sewers, as now or at any future time established by the Board of Selectmen.

Am't of estimate \$.....

Am't Paid \$.....

..... Owner

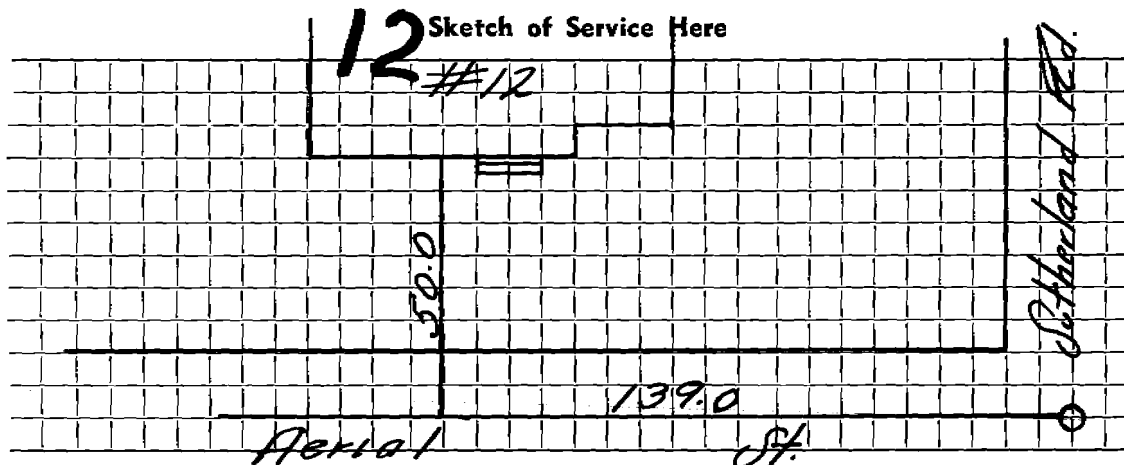

Connection made in Street.

Work completed 19..

Remarks: