

Name Nicolaos DiFantis

Service No. 21

Address 14 Aerial Street

JUL 24 1978

Location

Kind of Pipe

Size

Size of Main

~~Repair~~—Renewal—~~New Service~~ W.O. #6308


Location

Date	Material	Amount	Total	Date	Amount
6/12/78	Labor 166.45			5-19-78	Deposit 250.00
6/15/78	" 5.90	172.35		7/25/78	Paid 22.39
	10% O.H.	17.24	189.59		<u>272.39</u>
30'	6" Transite pipe @1.50		45.00		OUTSIDE
1	4" Donut		3.05	6/12-13/78	labor
2½	hrs. Trucking @3.00		7.50	1	6" X 10' Trans. pipe
3½	hrs. Backhoe @6.50		22.75	1	6" X 5' Trans. nipple
2	1" Insert Cup @.95		1.90	6	white bricks
4	1" Hose Clamps @.65		2.60	½	bag cement
			<u>272.39</u>	2	tons cold patch
					Sidewalk 5' X 25 long
					Street 9' X 25 long
				9	hrs. trucking
				5	hrs. backhoe
				2	hrs. comp. & roller
					<u>272.39</u>

DATE _____

TOWN OF LEXINGTON — BOARD OF PUBLIC WORKS
SEWER DIVISION

Sketch of Service Here

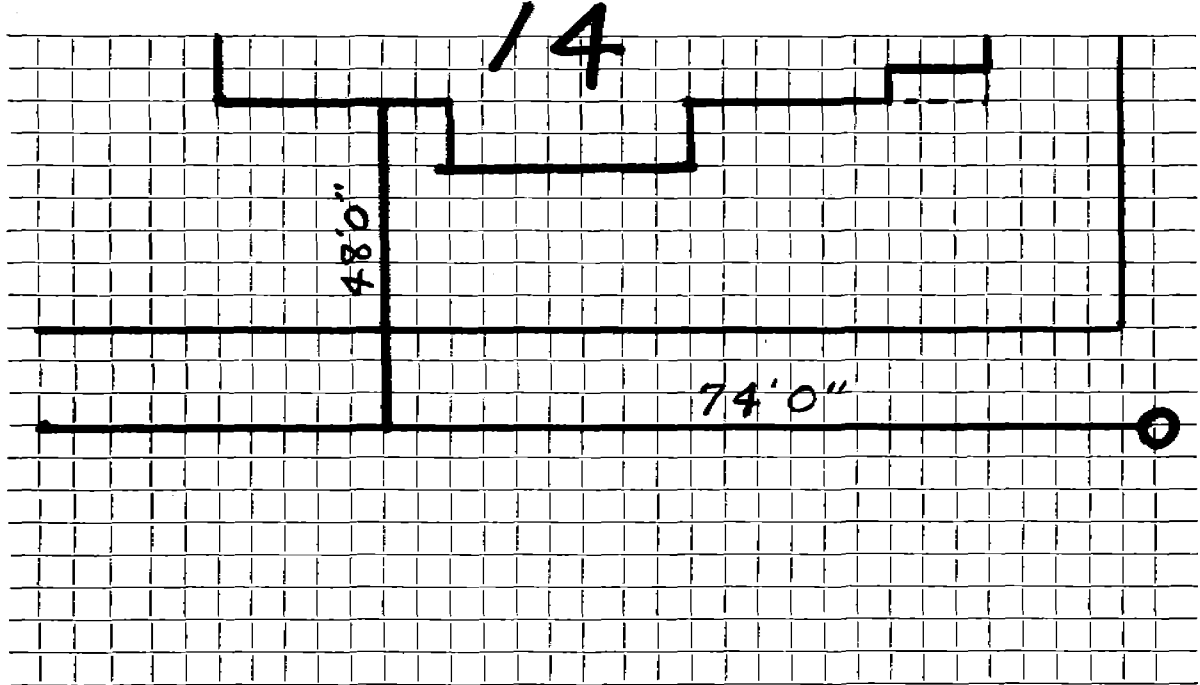

Connection made in Street. Work completed

Remarks:
.....
.....