

Name Clifton Kellogg

Service No. 19 9

Address 5 Aerial Street

Location 5 Aerial Street

Kind of Pipe

Size

Size of Main

~~Repair~~—Renewal—New Service

Location

Date	Material	Amount	Total	Date	Amount
Dec. 13, 44	Labor	27 30		Dec. 13, 44	110 00
	"	<u>42 34</u>	69 64	Dec 31 44	4 55
	10% Overhead		6 96		105 55
	40' - 6" Sewer Pipe @.22		8 80		
	Joint Comp.		2 40		
	Comp. 8 hrs. @1.75		14 00		
	Trucking 5 hrs. @.75		<u>3 75</u>		
			105.55		
	<b>Labor</b>				

TOWN OF LEXINGTON—DEPT. OF PUBLIC WORKS

SEWER DIVISION

DATE .....


NO. ....

The undersigned applies for the construction of a particular sewer connecting No. ....  
Street and hereby agrees to comply with the Rules and Regulations governing the construction and use of Particular  
Sewers, as now or at any future time established by the Board of Selectmen.

Am't of estimate \$.....

Am't Paid \$.....

..... Owner

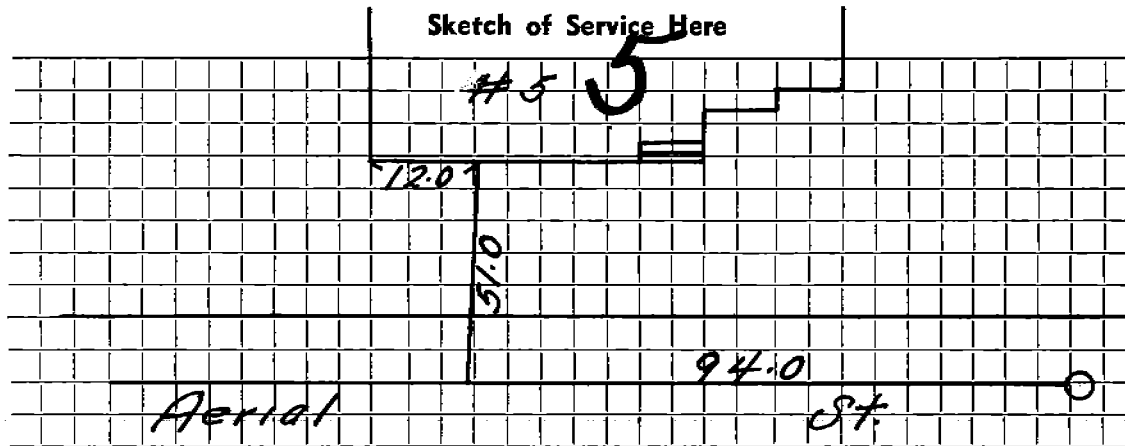

Connection made in ..... Street.

Work completed ..... 19..

Remarks: