

Name Joseph Phalen

Service No. 19 10

Address 6 Aerial Street

Location 6 Aerial Street

Kind of Pipe

Size

Size of Main

Repair—Renewal—New Service

Location

Date		Material	Amount	Total	Date		Location	Amount
Dec. 10,	45	Labor	49 48		Nov. 28,	45	Deposited	110 00
		"	<u>31 19</u>	80 67	Dec. 20,	46	Refunded	<u>7 81</u>
		10% Overhead		8 07				102 19
		40' - 6" Sewer Pipe		8 80				
		Joint Compound		2 40				
		Trucking 3 hrs.		<u>2 25</u>				
				102 19				
		Labor			10-9-64		ROOTS	

TOWN OF LEXINGTON—DEPT. OF PUBLIC WORKS  
**SEWER DIVISION**

DATE .....


NO. ....

The undersigned applies for the construction of a particular sewer connecting No. ....  
Street and hereby agrees to comply with the Rules and Regulations governing the construction and use of Particular  
Sewers, as now or at any future time established by the Board of Selectmen.

Am't of estimate \$.....

Am't Paid \$.....

..... Owner

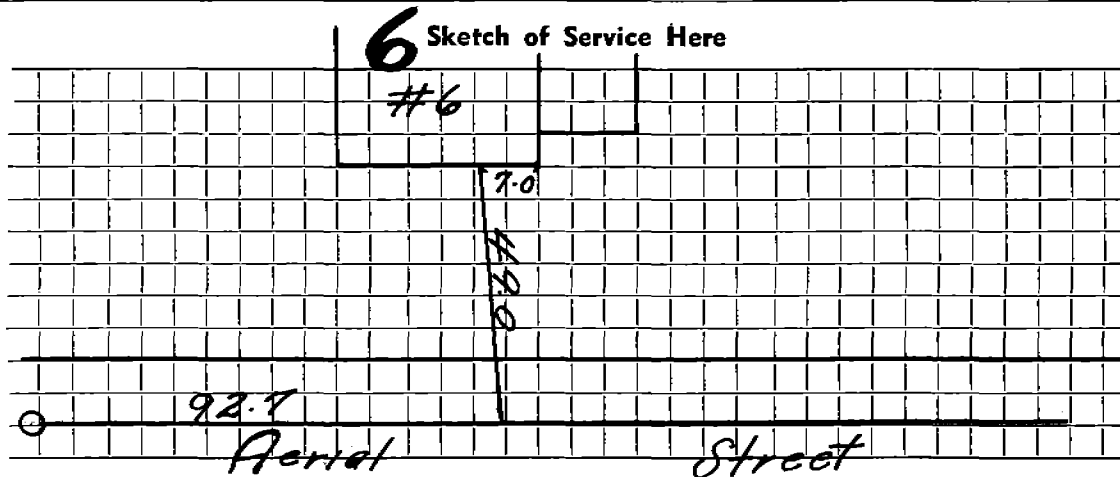

Connection made in ..... Street.

Work completed ..... 19..

Remarks: