

Name Harry Melconian

Service No. 7 1020

Address 7 Aerial Street

Lexington, Mass.

Location 7 Aerial Street

Kind of Pipe

Size

Size of Main

~~Repair~~ ~~Work~~ — New Service

Location

Date	Material	Amount	Total	Date	Amount
May 17, '46	Labor	48 26		May 16, 46	150 00
18, '46	"	67 20		Jan. 3, 47	26 41
19, '46	"	27 51	142 97		176 41
	10% Overhead		14 30		
	40' - 6" Sewer Pipe @ .256		10 24		
	10' - 4" Soil Pipe		5 00		
	Joint Compound		2 40		
	Trucking 2 hrs. @ .75		1 50		
			176 41		
	Labor				

TOWN OF LEXINGTON—DEPT. OF PUBLIC WORKS
SEWER DIVISION

DATE

NO.


The undersigned applies for the construction of a particular sewer connecting No.
Street and hereby agrees to comply with the Rules and Regulations governing the construction and use of Particular
Sewers, as now or at any future time established by the Board of Selectmen.

Am't of estimate \$.....

Am't Paid \$.....

..... Owner

Sketch of Service Here

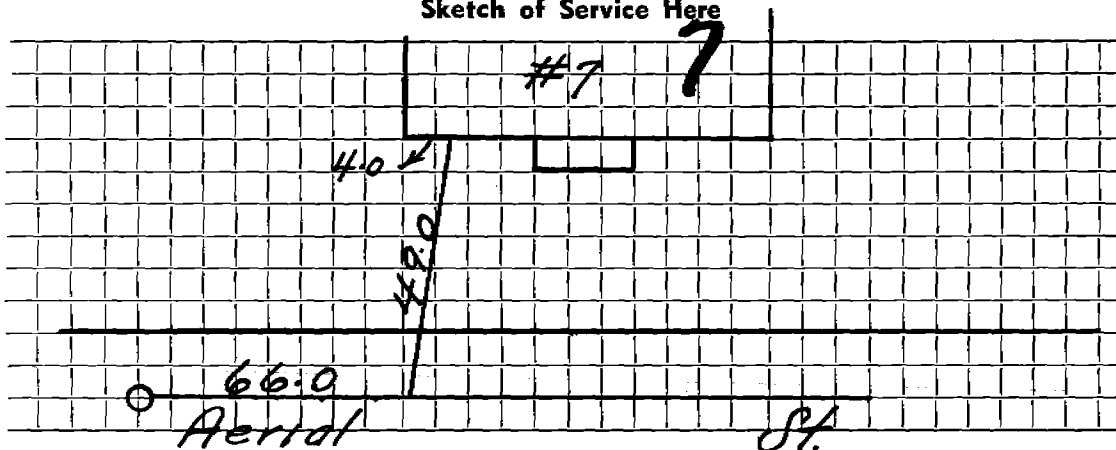

Connection made in Street.

Work completed 19..

Remarks: