

Name Charles R. Emerson

Service No. ¹² 5-1944

Address 9 Aerial Street

Location 9 Aerial Street

Kind of Pipe

Size

Size of Main

~~Repair~~ ~~Renewal~~ ~~New Service~~

Location

Date	Material	Amount	Total	Date	Amount
May 9, '44	Labor	23 20		May 8' 44	Paid 100 00
10, '44	"	42 00		June 19' 44	Abated 40 05
11, '44	"	36 80		Aug 2' 44	Paid 38 00
12, '44	"	<u>21 00</u>	123 00		<u>138 00</u>
	10% Overhead		12 30		
	Compressor - 14 hrs. @ 1.75		24 50		
	Trucking 2 hrs. @ .75		1 50		
	10' 4" Iron Soil Pipe @ .50		5 00		
	39' 6" V.C. Pipe @ .22		8 58	10-8-99	Service Blocked At M H
	1 1/4 Bend		67		Papers + mush
	Jointing Compound		<u>2 50</u>	45.02	Service Blocked
			178 05		IN M H
	Labor	6-9-44 Abated	<u>40 05</u>	10-2-03	Service Blocked
			138 00		At M. H. Put on
					Bi-weekly List

Hadley Press, Inc., Lexington

TOWN OF LEXINGTON—BOARD OF PUBLIC WORKS

SEWER DIVISION

DATE Mar 1. 1947

NO. _____


The undersigned applies for the construction of a particular sewer connecting No. 9 Aerial St., Tex. Street and hereby agrees to comply with the Rules and Regulations governing the construction and use of Particular Sewers, as now or at any future time established by the Board of Selectmen.

Am't. of Estimate \$ 160⁰⁰ This estimate based on the assumption that entry will be made from front of house.

Am't. Paid \$ _____

Charles R. Emerson Owner

Sketch of Service Here

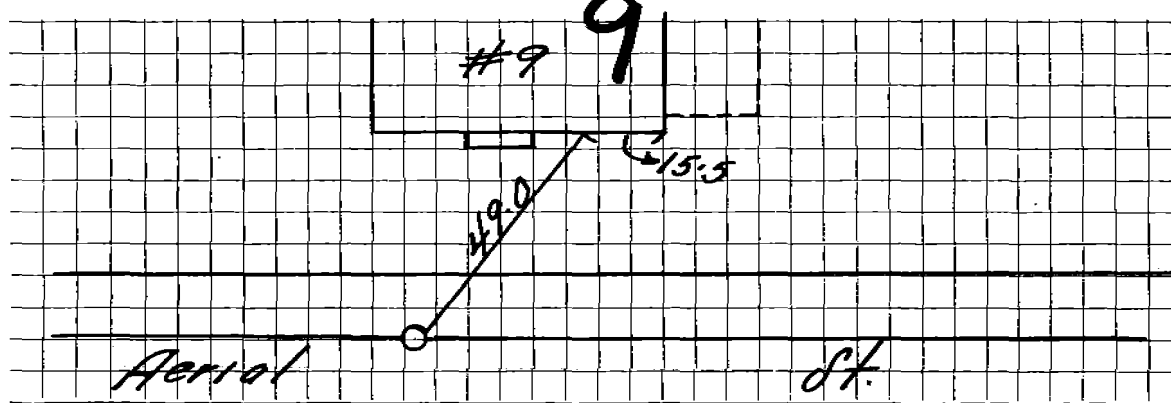

Connection made in _____ Street.

Work completed _____ 19

Remarks: