

Name Busa Realty Trust

Service No. #15

Address 11 Albemarle Avenue

Location

Kind of Pipe

Size

Size of Main

~~Repair-Renewal~~ New Service

WO #7087

Location *Comm 6-25-62*

Date	Material	Amount	Total	Date	Amount
4-13-62	Labor	87.01		3-27-62	100.00
	10% O.H.	8.70	95.71	<i>Deposit</i>	<i>76.22</i>
	40' 6" Transite Pipe @78		31.20		<i>176.22</i>
	1 22 $\frac{1}{2}$ " Transite Bend		6.21		
	1 11 $\frac{1}{4}$ " Transite Elbow		5.10		
	4 Hrs. Town Shovel @6.50		26.00		
	1 Hr. Trailer @3.00		3.00		
	3 Hrs. Trucking @3.00		9.00		
			<u>176.22</u>		
	<b>Labor</b>			5/1/67	
				7/22/65	SOLID MATTER (MAIN)
				10/28/65	Block (MAIN)
				Bill sent	

**TOWN OF LEXINGTON—DEPT. OF PUBLIC WORKS**  
**SEWER DIVISION**

DATE.....

NO.....

The undersigned applies for the construction of a particular sewer connecting No.....  
Street and hereby agrees to comply with the Rules and Regulations governing the construction and use of Particular  
Sewer, as now or at any future time established by the Board of Selectmen.


Am't of estimate \$.....

Am't Paid \$.....

..... Owner

---

**Sketch of Service Here**

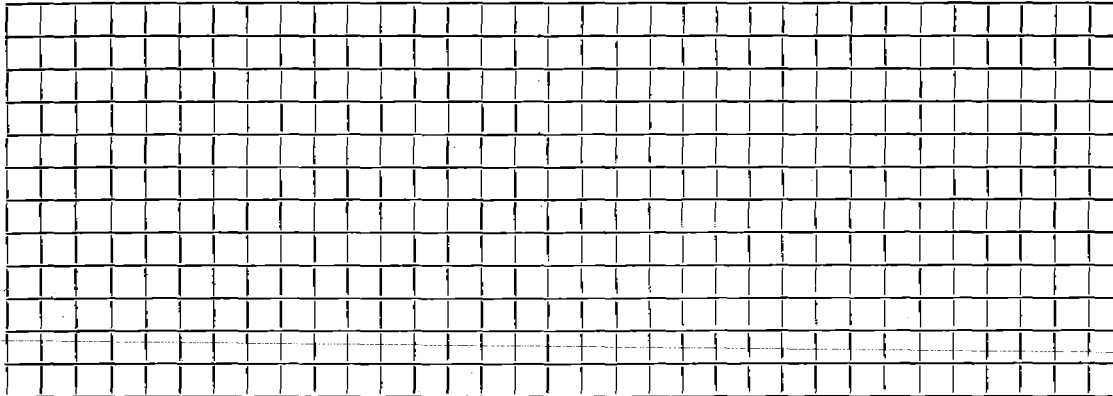

Connection made in..... Street. Work completed.....19..

Remarks: