

Name Joseph Flynn

Service No. 32

Address 22 Albermarle Avenue

Location

Kind of Pipe

Size

Size of Main

~~Repair - Renewal~~ - New Service

COM. 7-19-54

Location

Date	Material	Amount	Total	Date	Amount
6/1/54	Labor	57 63		3-29-54	150 00
	10% overhead	5 76	63 39	7-20-54	(21 96)
	56' - 6" sewer pipe @ .3087		17 29		128 04
	joint compound		3 36		
	5 2/3 hrs. Littlefield shovel @7.50		42 50		
	2 hrs. trucking @ .75		1 50		
			128 04		
	Labor				

TOWN OF LEXINGTON—DEPT. OF PUBLIC WORKS
SEWER DIVISION

DATE.....

NO.


The undersigned applies for the construction of a particular sewer connecting No.....
Street and hereby agrees to comply with the Rules and Regulations governing the construction and use of Particular
Sewers, as now or at any future time established by the Board of Selectmen.

Am't of estimate \$.

Am't Paid \$.

..... Owner

Sketch of Service Here

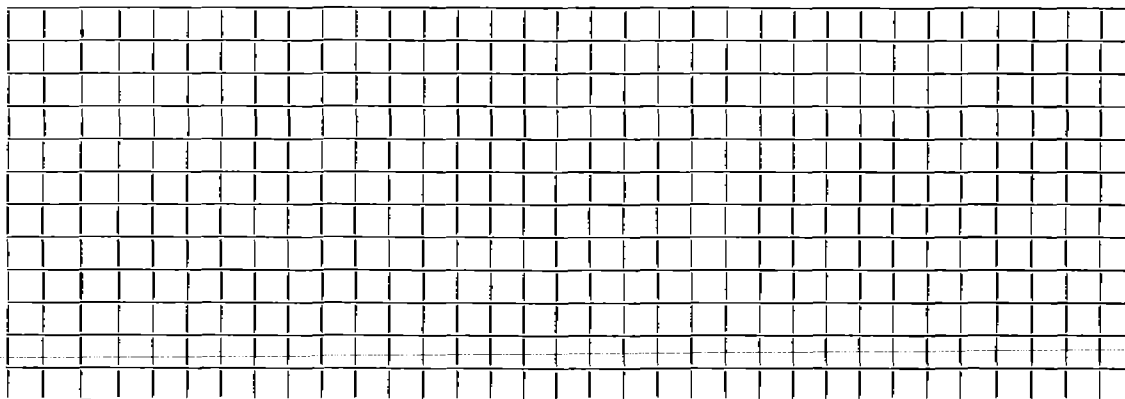

Connection made in..... Street.

Work completed.....19..

Remarks: