

Name

Service No.

Address 24 Albemarle Avenue

Lot #78-79 Sta. 4&62 right

Location

Kind of Pipe

Size

Size of Main

~~Repair to Existing~~ — New Service


Location

Date	Material	Amount	Total	Date	Amount
9-18-64	Labor	44 06			
	10% O.H.	4 41	48 47		
	30' 6" Transite pipe@.82		24 60		
	3 Hrs. Town shovel@6.50		19 50		
	1 Hr. Town truck@3.00		3 00		
			95 57		

DATE \_\_\_\_\_

**TOWN OF LEXINGTON — BOARD OF PUBLIC WORKS**  
**SEWER DIVISION**

Sketch of Service Here

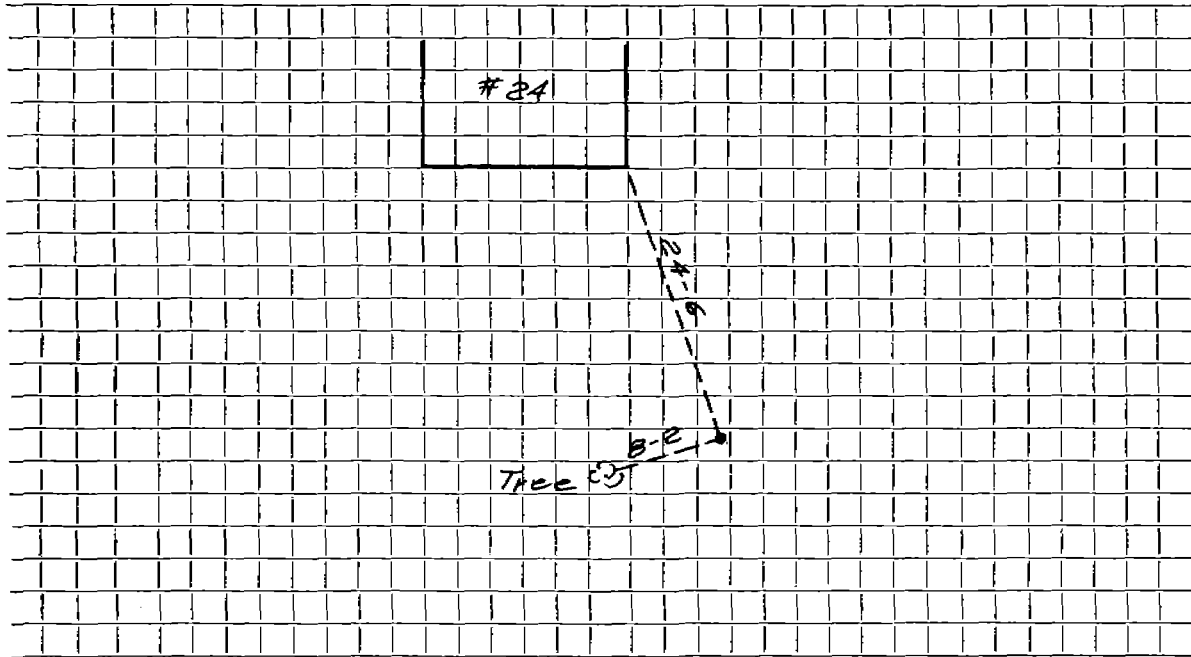

Connection made in ..... Street. Work completed .....

Remarks: .....

.....  
.....