

Name

Service No.

Address *25 Albemarle Ave.*

Lot 98

Location

Kind of Pipe

Size

Size of Main

Repair—Renewal—New Service

Location

Date

Material

Amount

Total

Date

Amount

9-18-64

10' 6" Transite Pipe

DATE _____

TOWN OF LEXINGTON — BOARD OF PUBLIC WORKS


SEWER DIVISION

190.52

Sketch of Service Here

Ø 58/5 Spk. - ~~178.89~~
INV. Service - ~~178.89~~
178.89

STA 0+0
+ Rawson Ave.

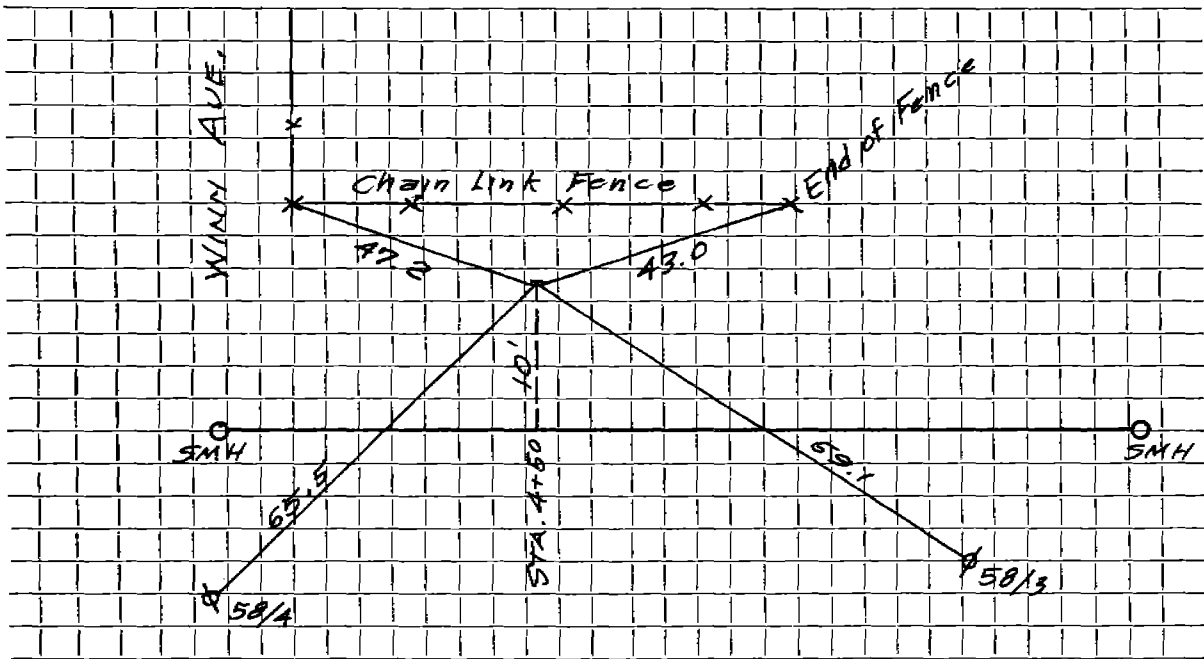

Connection made in Street. Work completed

Remarks:
.....
.....